




DATE \_\_\_\_\_

# TOWN OF LEXINGTON — BOARD OF PUBLIC WORKS

## WATER DIVISION

Sketch of Service Here

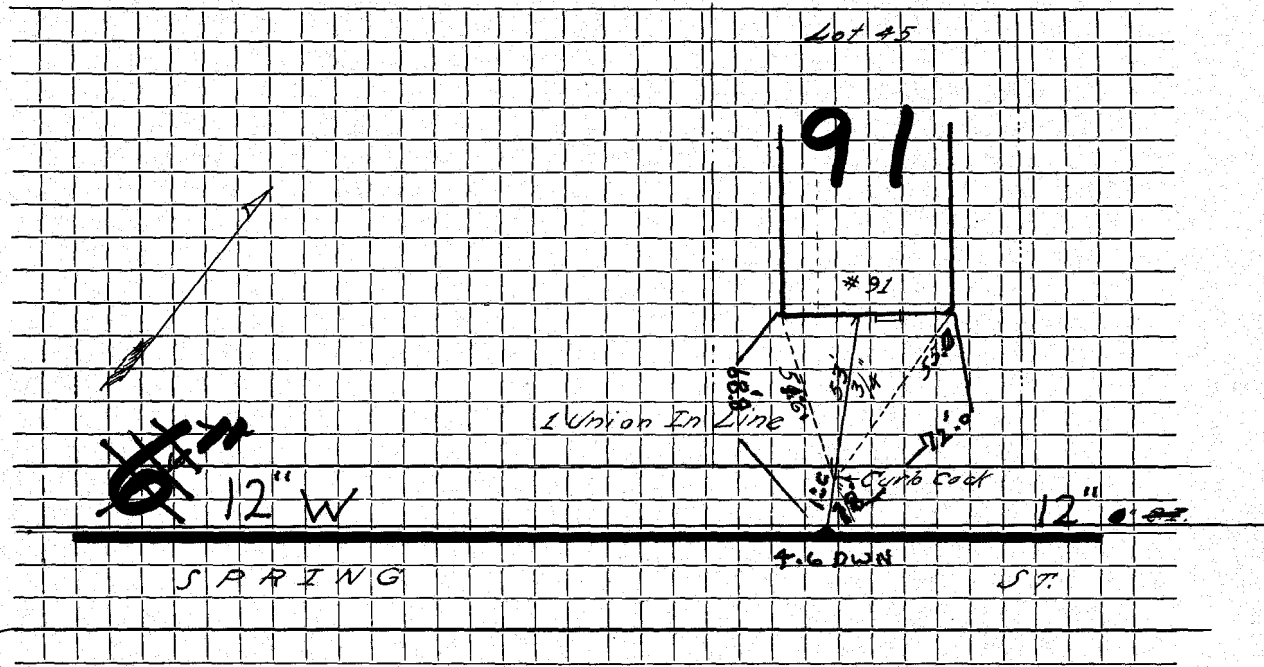

WOODCLIFFE RD

Connection made in \_\_\_\_\_ Street.

Work completed 2002 July Done!

Remarks: ..... 6" W Abandon 2002 .....