

WATER SERVICE RECORD

Name Joseph Chishalm

Service No. 381

Address 93 Spring Street

#6840, 7194

Location

Repair ~~Renewal~~ New Service


*Committed 4-2-56*

Date	Material	Amount	Total	Date	Amount
2-17-55	Labor	1 85		11-29-56	Deposited \$ 50 00
2-18-55	Labor	5 55	7 40	4-2-56	* Refund 6 15
	10% overhead		74		NON -CHARGE 43 85
	60' - 3/4" Copper tubing @ .50		30 00	<del>12-17-55</del>	<del>Labor 3 70</del>
	1 - 3/4" Cx 1/2 I.W.H. Stop & Waste		4 96	<del>15' - 3/4" Copper tubing @ .50</del>	<del>7 50</del>
	1 hr. trucking		75	<del>1 - 3/4" C. Corp cock</del>	<del>4 34</del>
			43 85	<del>1 - 3/4" C. Curb cock</del>	<del>5 94</del>
				<del>1 Box &amp; rod</del>	<del>4 62</del>
				<del>1 - 1/2 Straight tailpiece</del>	<del>50</del>
				<del>1 - 1/2 Offset tailpiece</del>	<del>50</del>
				<del>1 hr. trucking</del>	<del>75</del>
					<u>27 85</u>
July 01 1955	Demi 1" Copper 1" Corp 1" Curb Stop 1x 3/4 Red buffle box			* Ref. \$6.15 made payable to Town to apply on S.N.C #224	

TOWN OF LEXINGTON — BOARD OF PUBLIC WORKS

WATER DIVISION

Sketch of Service Here  
SPRING ST

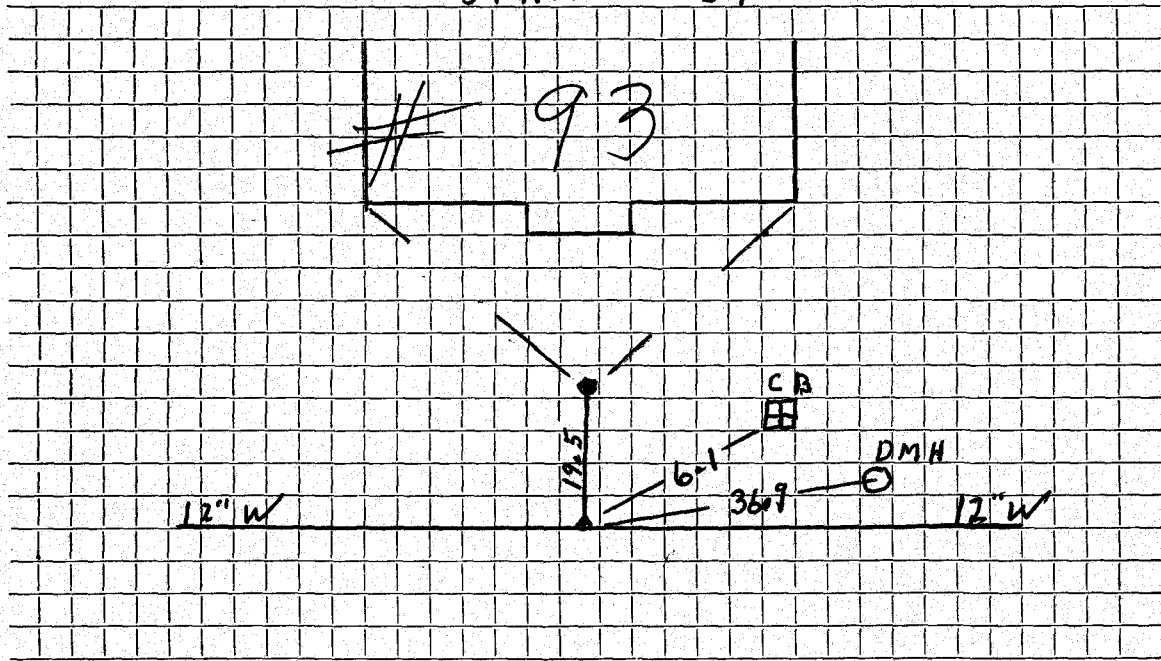

Connection made in ..... Street. Work completed .....

Remarks: .....  
.....  
.....