

WATER SERVICE RECORD

Name Paul Drury

Service No. 20

Address 95 Spring Street

Location

~~RENEWAL~~—Renewal—~~NEW SERVICE~~ W.O. # 2264


FEB 10 1975

Date		Material	Amount		Total		Date		Amount		
7-16-74		Labor	38	56			7-16-74	Deposit	350	00	
		10% O.H.	3	86	42	42	3-11-75	Retired	134	75	
	44'	3/4" Copper Tubing @	1	05	46	20			125	35	
	1	Wheel handle			11	13			<u>Non-Charge Work</u>		
	2	Hrs. Trucking	3	00	6	00	9-11-74	Labor	9	01	
	3	Hrs. Town Shovel	6	50	19	50		10'	3/4" Copper Tubing @1.05	10	50
					125	25		1	Lead Adapter	4	55
								1	Box and Rod	10	00
								1	3/4" Curb Cock	12	45
								1	Hr. Trucking @3.00	3	00
								2	Hrs. Pickup @ 1.50	3	00
								1	Hr. Loader	4	00
							Demi	1/	Patch 2'x4'	5	28
							July 02	16'	1" Copper	61	79
									1" Corp		
									1" Curb		
									1x3/4 Red		
									bufflo box		

TOWN OF LEXINGTON — BOARD OF PUBLIC WORKS

WATER DIVISION

Sketch of Service Here

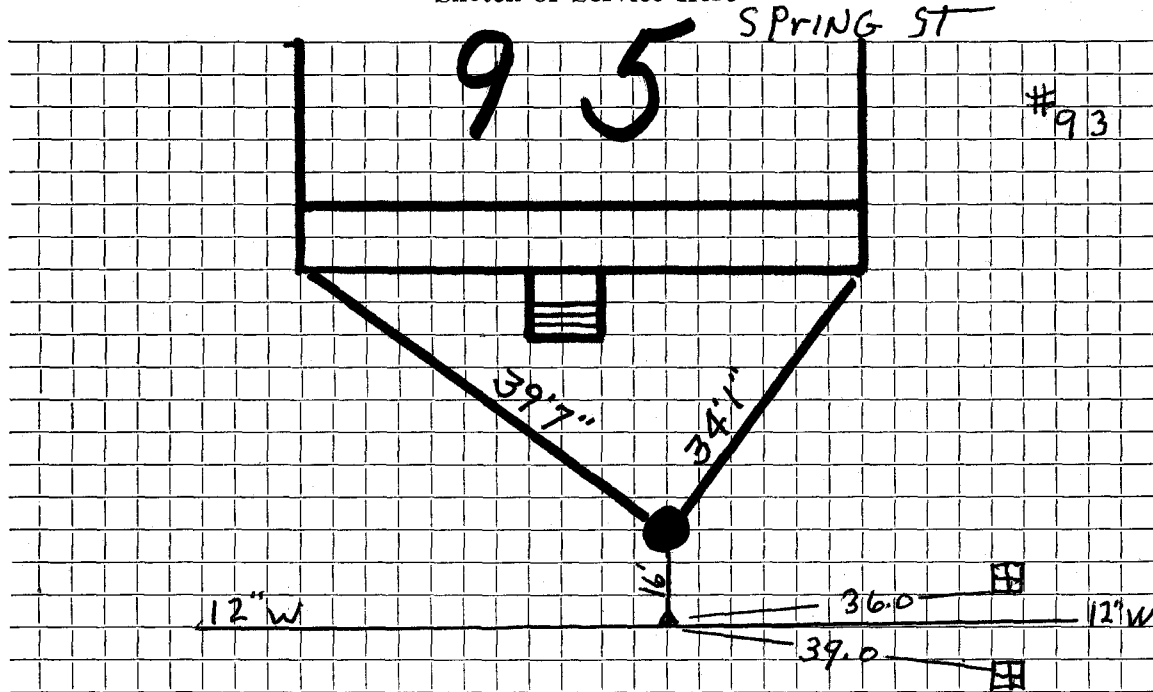

Connection made in Street. Work completed 2002.....

Remarks: Original Service 12-27-'28' (Tic from house MAY have changed 2002).....