


DATE _____

TOWN OF LEXINGTON — BOARD OF PUBLIC WORKS

WATER DIVISION

Sketch of Service Here

SPRING ST

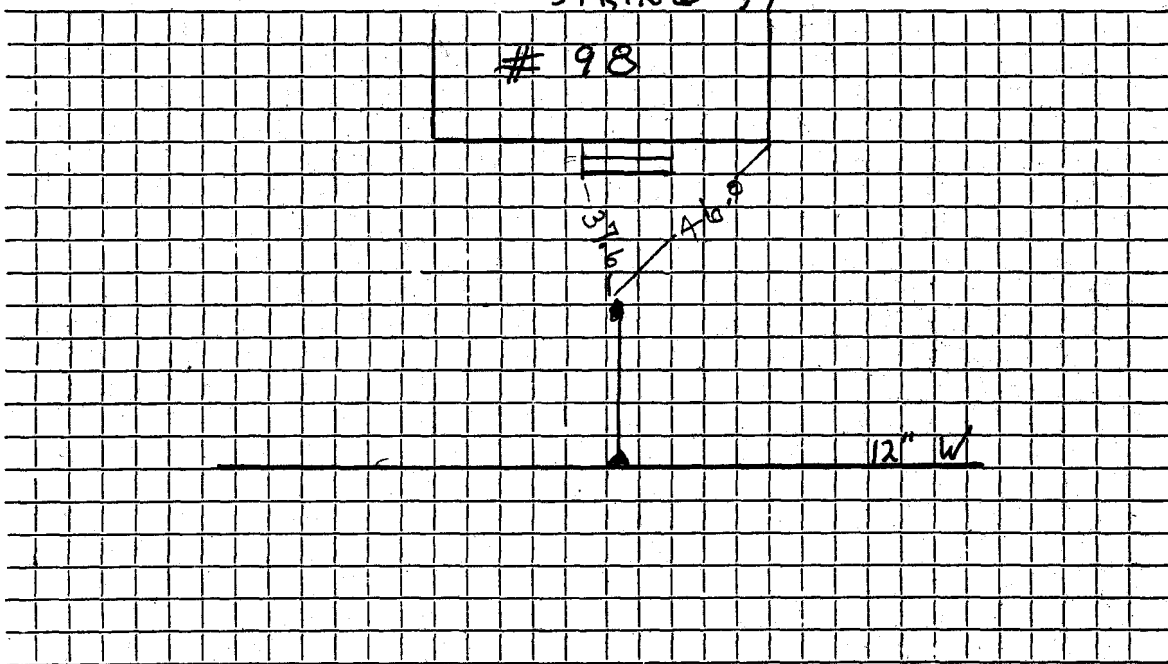

Connection made in Street. Work completed 2002 Reml.....

Remarks: Ties M.A.Y. have changed 2002.....