

WATER SERVICE RECORD

Name B. David Deloury

Service No.

Address 99 SPRING ST.

Location

~~RENEW~~ - Renewal - ~~NEW SERVICE~~


Date	Material	Amount	Total	Date	Amount	
	<u>NON CHARGE</u>				<u>NON CHARGE</u>	
1/5/55	Labor	6 90		1/5/55	Labor	6 90
	10% overhead	69.	7 59		7' - 3/4" copper tubing@ .35	2 45
	33' - 3/4" copper tubing@ .35	11 55			1 - 3/4" C. corp-cock	4 33
	1 - 3/4" C x 1/2 I.W.H. stop & waste	4 00			1 - 3/4" C. curb-cock	4 67
	3 hrs. Littlefield shovel@7.50	22 50			1 box and rod	3 90
	1 hr. trucking		75		1 - 1/2 offset tail piece	50
			46 39		1 - 1/2 straight tail piece	50
					1 hr. Littlefield shovel	7 50
					1 hr. trucking	75
					DEMI 12' 1" Copper	31 50
					July 02 1" Corp	
					1" Curb	
					1x 3/4 Red	
					bufflo box	
	NO CHARGE AS RENEWAL WAS NECESSARY DUE TO SEWER MAIN BREAKS.					

TOWN OF LEXINGTON — BOARD OF PUBLIC WORKS

WATER DIVISION

Sketch of Service Here

SPRING ST

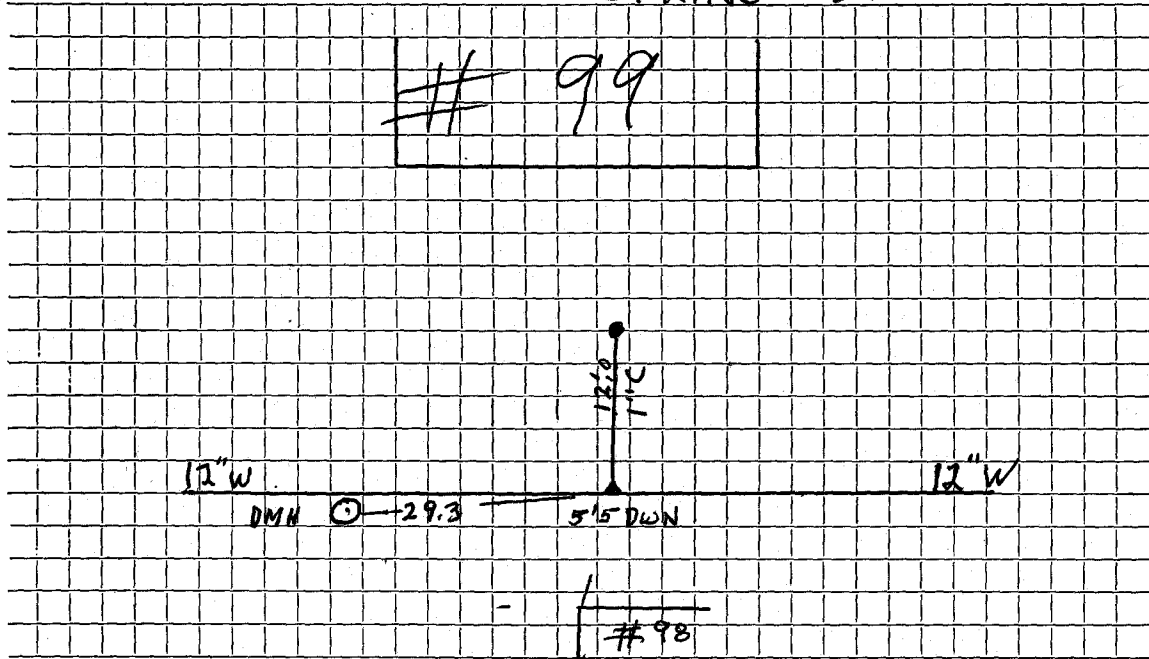

Connection made in Street. Work completed 2002

Remarks: Original Service 9-21-28