


DATE 5/13/19

TOWN OF LEXINGTON — BOARD OF PUBLIC WORKS

WATER DIVISION

Sketch of Service Here

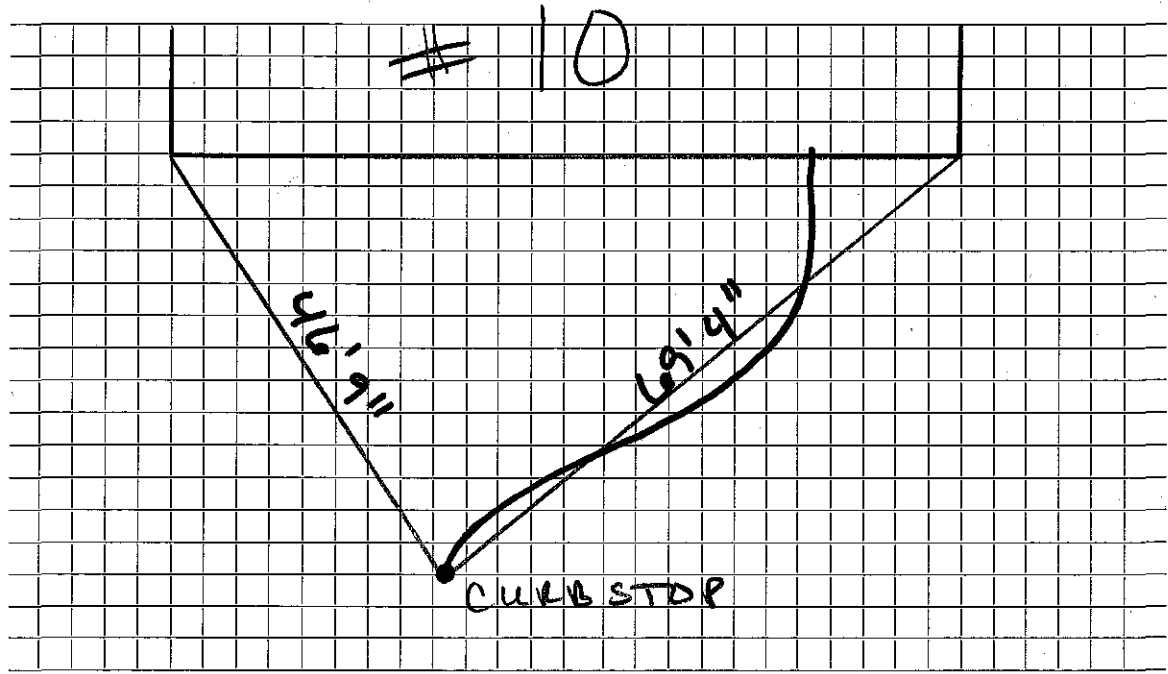

Connection made in... Springdale Street. Work completed

Remarks:

.....

.....