


DATE _____

TOWN OF LEXINGTON — BOARD OF PUBLIC WORKS

WATER DIVISION

Sketch of Service Here

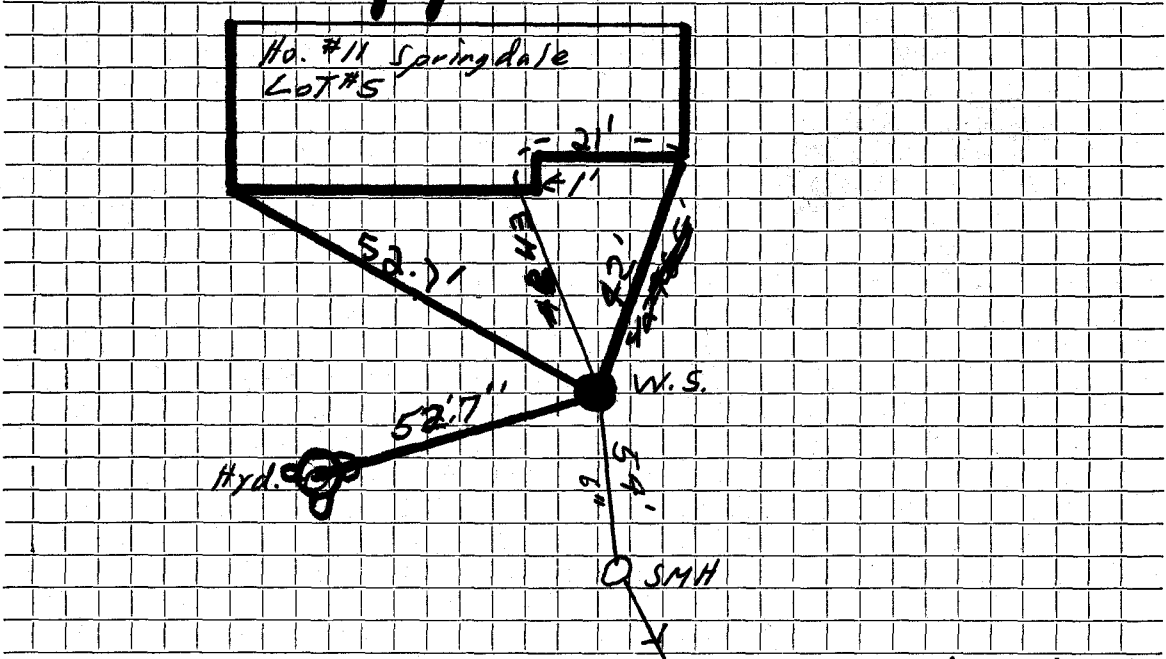

Connection made in Springdale... Road..... Street.

Work completed ... 9/30/75.....

Remarks:
.....
.....