

DATE _____


TOWN OF LEXINGTON — BOARD OF PUBLIC WORKS

WATER DIVISION

Sketch of Service Here

12

No. # 12 Springdale
Lot # 7

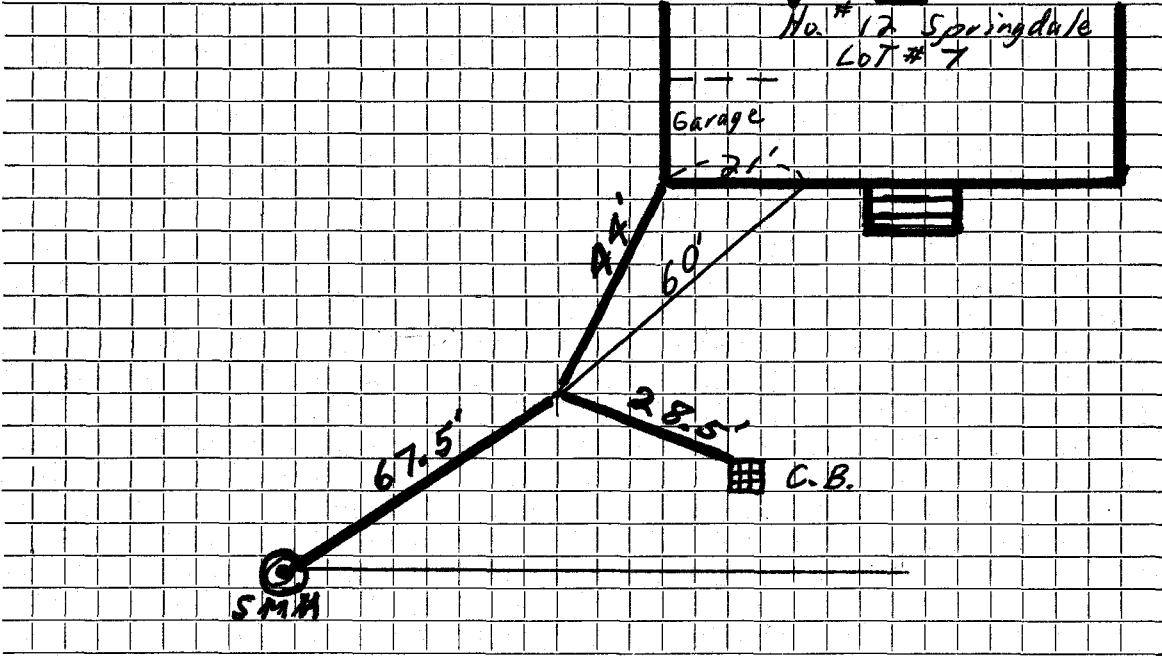

Connection made in ... *Springdale* Street.

Work completed

Remarks:
.....
.....