




DATE \_\_\_\_\_




TOWN OF LEXINGTON — BOARD OF PUBLIC WORKS

60. WATER DIVISION

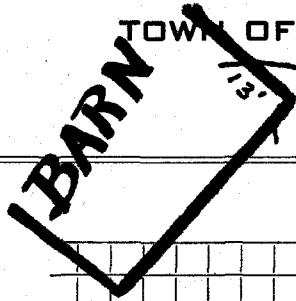

60'  $\frac{3}{4}$ " C.

Sketch of Service Here

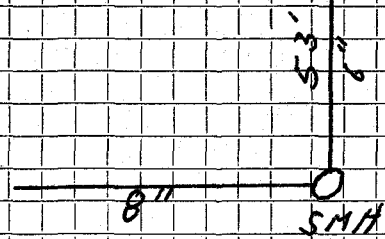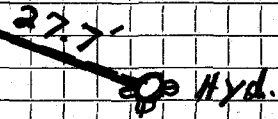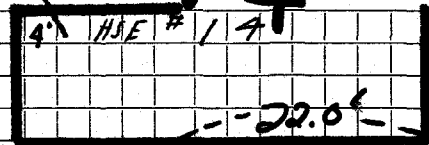

Connection made in S. Springdale Street. Work completed 9/30/75

Remarks: Water service to barn from house 60' copper  $\frac{3}{4}$ "