



DATE \_\_\_\_\_

TOWN OF LEXINGTON — BOARD OF PUBLIC WORKS


WATER DIVISION

3

Sketch of Service Here

Ho. #3 Springdale

LOT #2

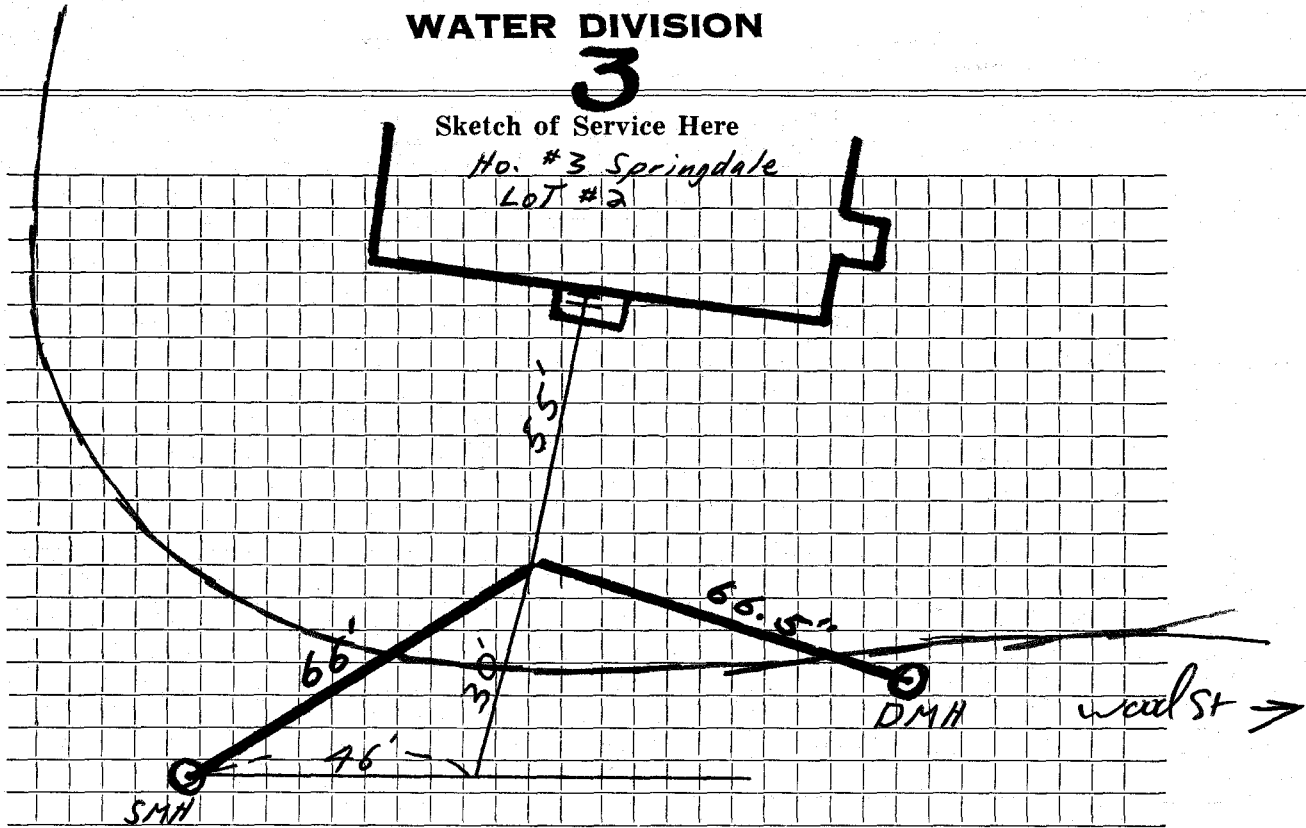

Connection made in ..*Springdale*..... Street.      Work completed .....

Remarks: .....

.....

.....