

WATER SERVICE RECORD

Name Fred Liljeholm

Service No. 388

Address 1 Stearns Road

Location

~~RENEWAL~~ - New Service


Com. 12-21-53

Date	Material	Amount	Total	Date	Amount
12/11/53	Labor	9 50		12-8-53	Deposited 50 00
	10% overhead	95	10 45	12-21-53	Refunded (5 28)
	40' - 3/4" copper tubing @ .3629		14 52		<u>NON CHARGE</u> 44 72
	1 - 3/4" C x 1/2 I.W.H. stop & waste		4 00		Service was in to curb:
	2 hrs. Littlefield shovel @ 7.50		15 00	1 - 1/2 straight tail piece	50
	1 hr. trucking		75	1 - 1/2 offset tail piece	50
			<u>44 72</u>		<u>1 00</u>

DATE _____

TOWN OF LEXINGTON — BOARD OF PUBLIC WORKS

WATER DIVISION

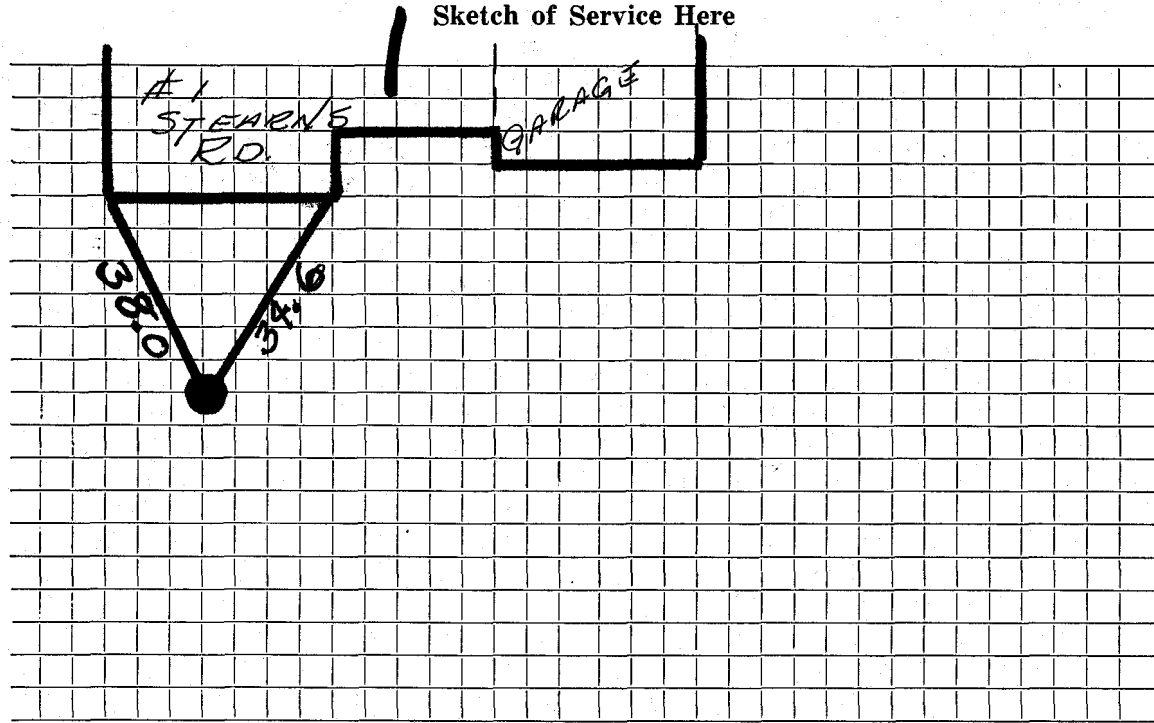

Connection made in Street. Work completed

Remarks:
.....
.....