

Name Thomas L. Stoffle

Service No. 163 # 4301
3406

Address 12 Stedman Road

Lexington, Mass.

Location

12 Stedman Road

Kind of Pipe

Size

Size of Main

~~REPAIRS~~ NEW SERVICE

Corn 12/31/47

Location

Date	Material	Amount	Total	Date		Amount
11/15/47	Labor	7 60	7 60	11/21/47	Deposited	50 00
	10% Overhead		76	12/31/47	Refunded	14 54
	60' 3/4" Cop. Tubing @ 27		16 20			35 46
	1 3/4" Cx 1/2" I.W.H. S&W		3 15		Non-Charge	
	1 hr. Hired Shovel @ 7.00		7 00	11/15/47	Labor	7 80
	1 hr. Trucking		75	27' 3/4" Copper Tubing		7 02
			35 46	1 3/4" C. Corp. Cock		5 00
				1 3/4" Cx 3/4" C. Gurb-cock		3 68
				1 3/4" Cx 3/4" C Union (3 pts.)		1 32
				1 Box and Rod		4 26
				1 1/2" Offset Tail Piece		30
				1 1/2" Str. Tail Piece		30
	Labor			1 hr. Hired Shovel		7 00
				1 hr. Trucking		75
						35 45

DATE _____

TOWN OF LEXINGTON – BOARD OF PUBLIC WORKS

WATER DIVISION

The undersigned applies for a supply of water at No..... St. and hereby agrees to comply with the rules and regulations as now, or at any future time, established by the Board of Selectmen.

Am't of Estimate \$.....

Owner


Am't Paid \$.....

Address

Builder

610 Haltham Street

Sketch of Service Here

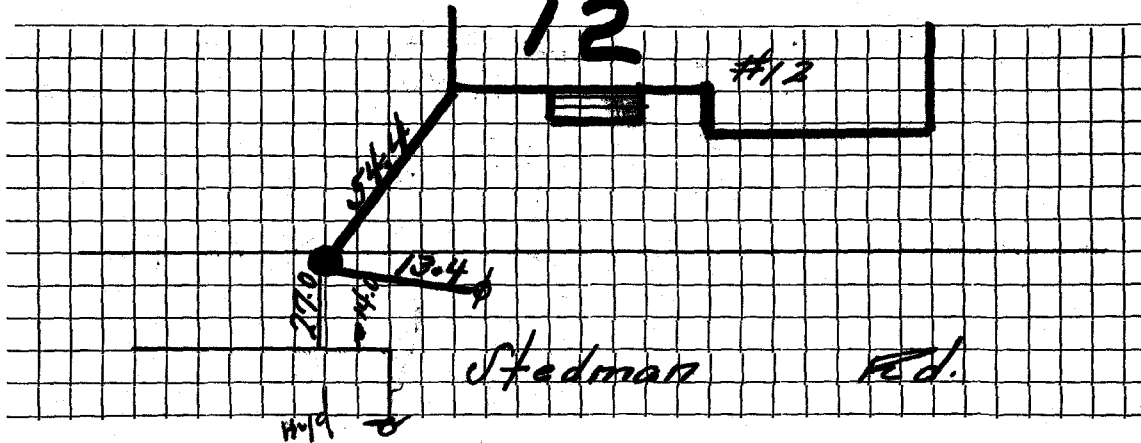

Connection made in Street.

Work completed19

Remarks: