


DATE 4/19/90
P.A.B.

TOWN OF LEXINGTON — BOARD OF PUBLIC WORKS

WATER DIVISION

3 Sketch of Service Here

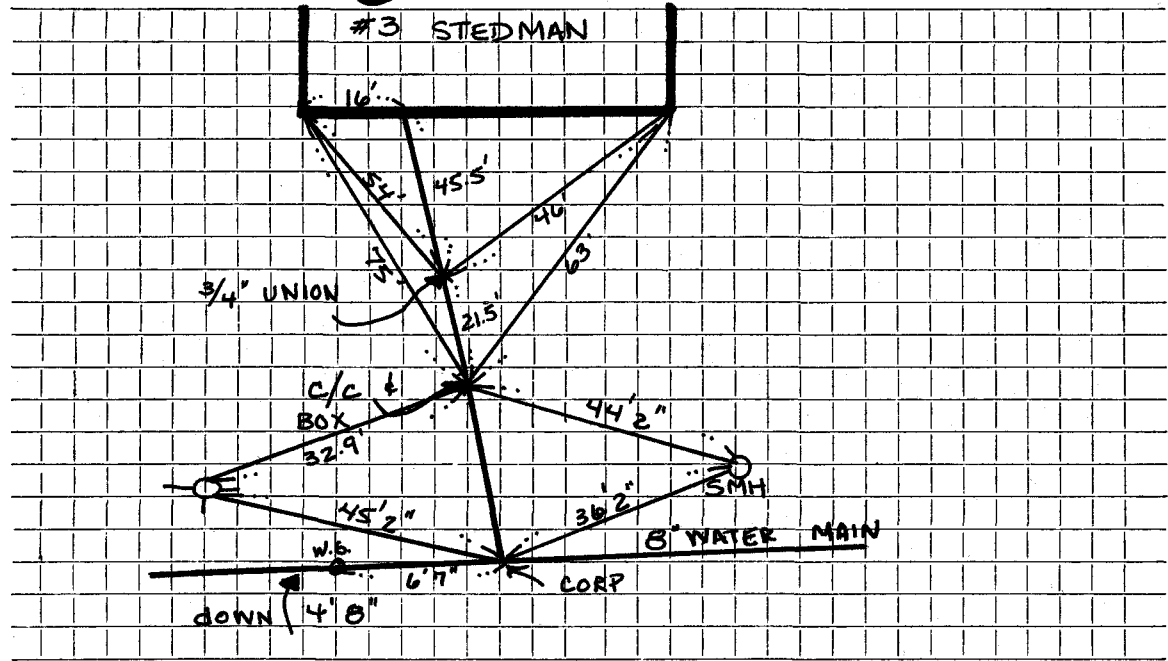

Connection made in STEDMAN Rd. Street. Work completed

Remarks: INSPECTED: P.A. BARROWS Original Service 10-26-35

CONTRACTOR: ARLEX