

WATER SERVICE RECORD

Name Roakwood Sprinkler Company

Service No. 123

Address Stedman Road (Franklin School)

Location

~~Repair - Renewal~~ New Service


Comm. 9/30/57

Date	Material	Amount	Total	Date	Amount	
6/26/57	Labor	122 37		6-21-57	Deposit	\$ 800 00
6/27/57	"	114 21		10-16-57	Paid	11 47
6/28/57	"	85 61				\$ 811 47
		322 19				
	10% overhead	32 22	354.41			
	144' - 1" C.L. Pipe @ 1.74		250 56			
	1 - 6x6 Tapping Sleeve & Gate		115 25	6-16-80	INST 6" line & Hyd From Exist. 6"	
	1 Gate Box		14 85		4" DIP through Rear of Build	
	Joint Compound		5 90	1	4" & 2" Tee	
	6 hrs. Town Shovel @ 6.50		39.00	2	2" Tee's	
	6 hrs. Trucking @ .75		4 50		NOT INSP by Water Dept	
	1 hrs. Trucking		3 00			
	1 hr. Rodgers Trailer		3 00			
	4 hrs. Hough Loader @ 3.00		12 00			
	3 hrs. Compressor @ 3.00		9 00			
			811.47			Bill sent 10/7/57

TOWN OF LEXINGTON — BOARD OF PUBLIC WORKS

WATER DIVISION

Sketch of Service Here

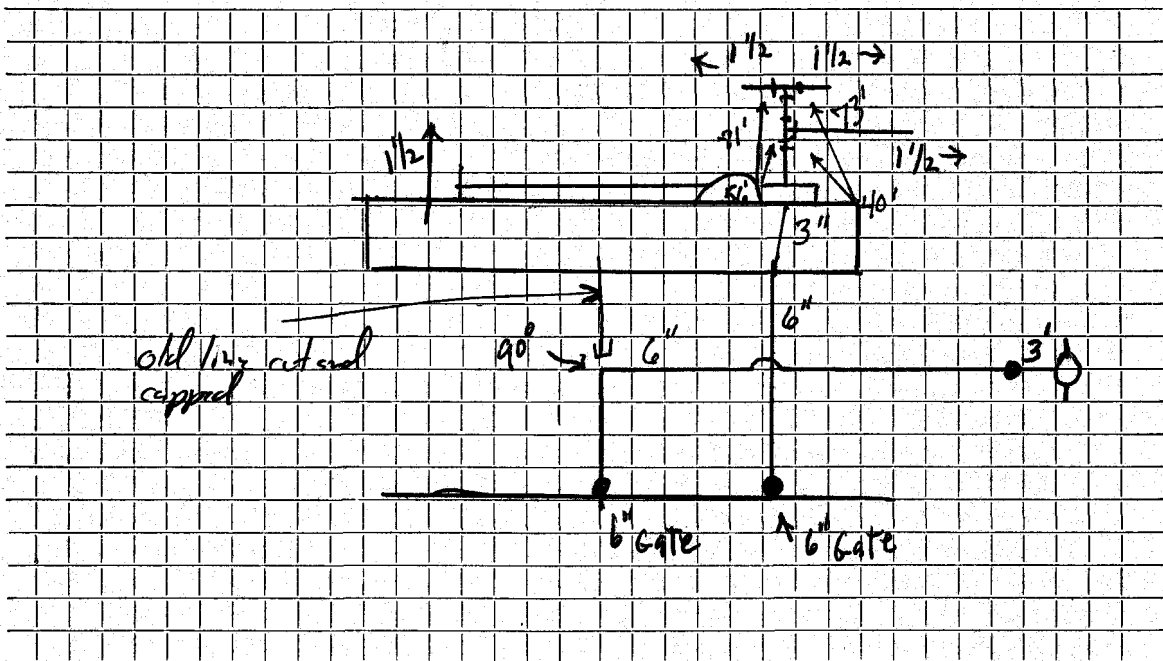

Connection made in Street. Work completed

Remarks: *This Service not insp. by Water Dept. ... 4" out Back of Build Reduced To 2" Copper*
6" To Hyd. Insp. See Gate Books.