

Name Everett S. Emery

Service No. ~~25~~ 2582

Address 3 Stetson Street

Lexington, Mass.

Location 3 Stetson Street

Kind of Pipe

Size

Size of Main

Repair—Renewal—New Service

Location

Date	Material	Amount	Total	Date	Amount
Oct. 6, '45	Labor	30 65	30 65	Oct 6' 45	50 06
	10% Overhead		3 07	Nov. 21 46	7 21
	30' - $\frac{3}{4}$ " Copper Tubing		5 73		42 79
	1- $\frac{3}{4}$ " C x $\frac{1}{2}$ " I.W.H. Stop & Waste		2 59		
	Trucking 1 hr.		75		
			42 79		
	Labor				

Deposited
Refunded

Hidley Press, Inc., Lexington

DATE _____

TOWN OF LEXINGTON—BOARD OF PUBLIC WORKS

WATER DIVISION

The undersigned applies for a supply of water at No. _____ St. and hereby agrees to comply with the rules and regulations as now, or at any future time, established by the Board of Selectmen.

Am't. of Estimate \$ _____


Owner _____

Am't. Paid \$ _____

Address _____

Builder _____

Sketch of Service Here

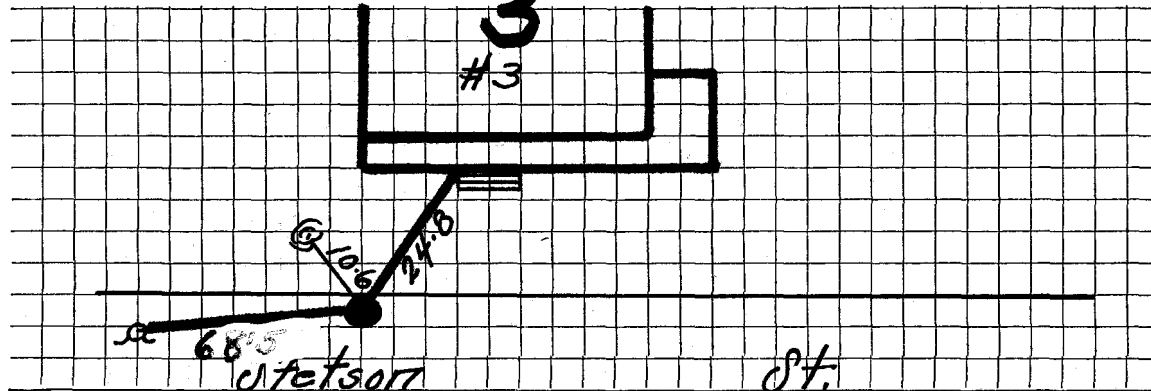

Connection made in _____ Street. Work completed _____ 19

Remarks: Original Service 9-18-29 - Renewed To Curb 1939