

Name Builder: Merle Miller, Mt. Vernon St., Malden,

Service No. ~~55~~ 2583

Address Owner: ~~Marion Brown, 19 Oakland Street,~~

4 Stetson Rd

Location 4 Stetson Road.

Kind of Pipe

Size

Size of Main

Repair—Renewal—New Service

Location

Date 1939	Material	Amount	Total	Date	Amount
Sept. 12 <i>com.</i> 10/30/39	2 hrs. @ 60¢	1 20		August 22, 1939	33 00
	10% Overhead	<u>12</u>	1 32	Deposited	
	68' 3/4" Copper tubing @ 15¢	10 20	10 20		
	1 3/4" C x 1/2" I.S. & W.		2 10		
	1 3/4" C. Union (3 part)		88		
	2 hrs. trucking @ 75¢		<u>1 50</u>		
			<u>16 00</u>		
	Charge: Flat Rate		\$33 00		
	Labor				

Hadley Press, Inc., Lexington

DATE 12-7-19

TOWN OF LEXINGTON—BOARD OF PUBLIC WORKS

WATER DIVISION

The undersigned applies for a supply of water at No. 43 Stetson St. and hereby agrees to comply with the rules and regulations as now, or at any future time, established by the Board of Selectmen.

Am't. of Estimate \$ 33⁰⁰

Owner Marion Brown


Am't. Paid \$ _____

Address 19 Oakland St

Builder Merle Miller

Lexington

Sketch of Service Here

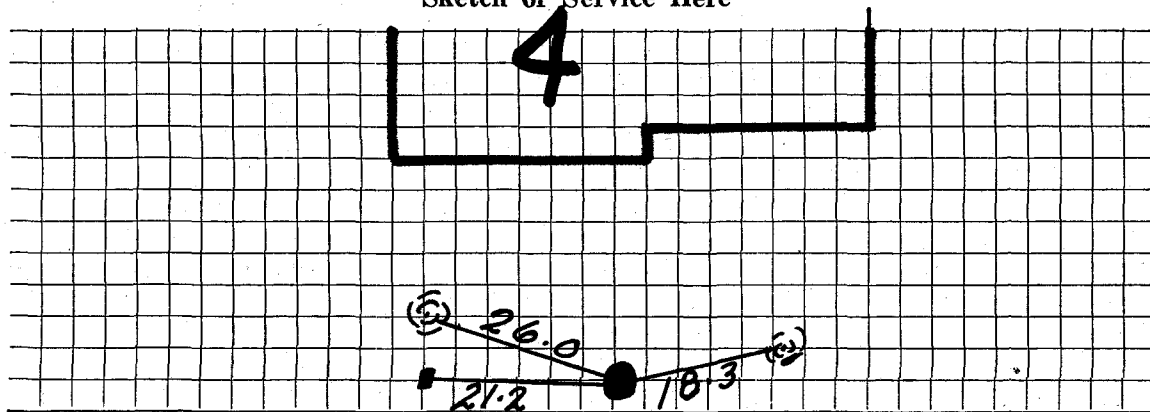

125-00
03
156.00

Connection made in _____ Street. Work completed _____ 19

Remarks: