

## WATER SERVICE RECORD

Name Richard Nye

Service No. 45

Address 6 Stetson Street

Location

~~Repair~~ ~~Renewal~~ ~~New Service~~ WO #4764

OCT 25 1976


Date	Material	Amount	Total	Date	Amount
8/5/76	labor	111. 05		8-4-76	600.00
	10%OH	11. 11	122. 16	11-25-76	300.83
75'	3/4" Copper @ .65		48. 75		299.17
1	Curb Box & Rod		15. 40		
1	3/4" Wheel Handle		14. 53		
	8 X 14X4 Sidewalk Patch		74. 64		
2	hrs. shovel @ 6.50		13. 00		
2	hrs. trucking @ 3.00		6. 00		
1	3/4" 3 Part Union		4. 69		
			299. 17		

DATE \_\_\_\_\_

TOWN OF LEXINGTON — BOARD OF PUBLIC WORKS

**WATER DIVISION**

Sketch of Service Here

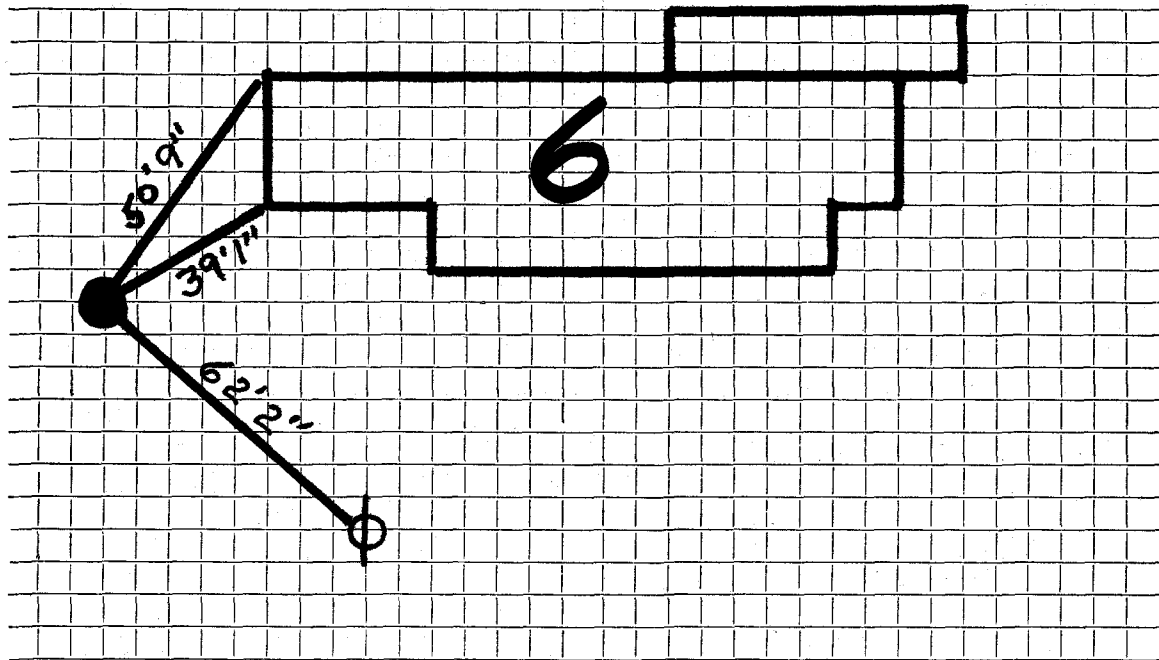

Connection made in ..... Street. Work completed .....

Remarks: *Renewed Main To Curb. 1939.* .....

.....  
.....