

Name

Service No. 488

Address 11 Stevens Road

#5556

Location ~~XXXXXXXXXXXXXXXXXXXX~~

Kind of Pipe

Size

Size of Main

Repair—Renewal—New Service

Location

Date

Material

Amount

Total

Date

Amount

6-9-05 c T

Outside  
3/4 Copper

Labor

Hidley Press, Inc., Lexington

# TOWN OF LEXINGTON—BOARD OF PUBLIC WORKS

## WATER DIVISION

The undersigned applies for a supply of water at No. \_\_\_\_\_ St. and hereby agrees to comply with the rules and regulations as now, or at any future time, established by the Board of Selectmen.

Am't. of Estimate \$ \_\_\_\_\_

Owner

S. L. Parker.


Am't. Paid \$ \_\_\_\_\_

Address

11 #2 Carey St.

Builder \_\_\_\_\_

Sketch of Service Here

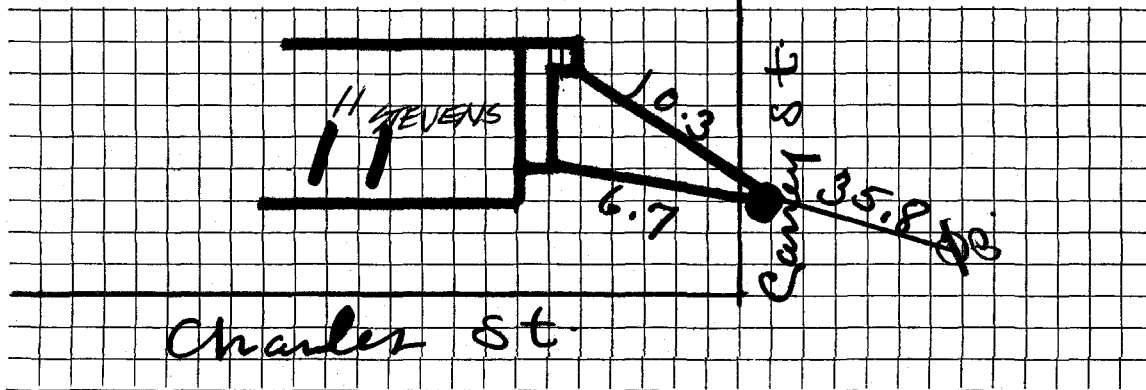

Connection made in \_\_\_\_\_ Street.

Work completed \_\_\_\_\_ 19

Remarks: