

Name ~~Allen J. MacGilvray~~ Linda Niland

Service No. ~~45~~ 489

Address 12 ~~XXXXXX~~ Stevens Road

Location

Kind of Pipe

Size

Size of Main

~~Repair~~—Renewal—~~New Service~~

Location

Date 1942	Material	Amount	Total	Date	Amount
Sept. 13,	2 hrs. @ 65¢	1 30		August 27, 1942 Reprinted	10.00
<i>Jan 10/3/42</i>	10% Overhead	13	1 43	October 14, 1942 Reprinted	.14
	16' 1" C.L. Pipe @ 25¢		4 00		<u>9 86</u>
	3' 3/4" Copper tubing @ 21¢		63	<u>Curb to Main-Not Chargeable</u>	
	1 3/4" C x 1/2" I.W.H.S.& W.		2 35	9' 3/4" Cop. tub. @ 21¢	1 89
	1 1" I x 3/4" C. Union		70	1 3/4" " corp. cock	2 25
	1 hr. trucking		75	1 3/4" "x 1" I. curb cock	2 75
			<u>9 86</u>	1 1/2" Offset tail piece	38
	Say \$10.00			1 Box and Rod	1 65
				1 hr. trucking	75
				Labor	<u>1 30</u>
					10 97
	Labor				

Hidley Press, Inc., Lexington

DATE August 27, 1942

TOWN OF LEXINGTON—BOARD OF PUBLIC WORKS
WATER DIVISION

The undersigned applies for a supply of water at No. 12 Cary Street St. and hereby agrees to comply with the rules and regulations as now, or at any future time, established by the Board of Selectmen.

Am't. of Estimate \$ _____

Owner

Allen J. Mac Gilroy

Am't. Paid \$ _____


Address

12 Cary St

Builder _____

Spring Tu Mass

Sketch of Service Here

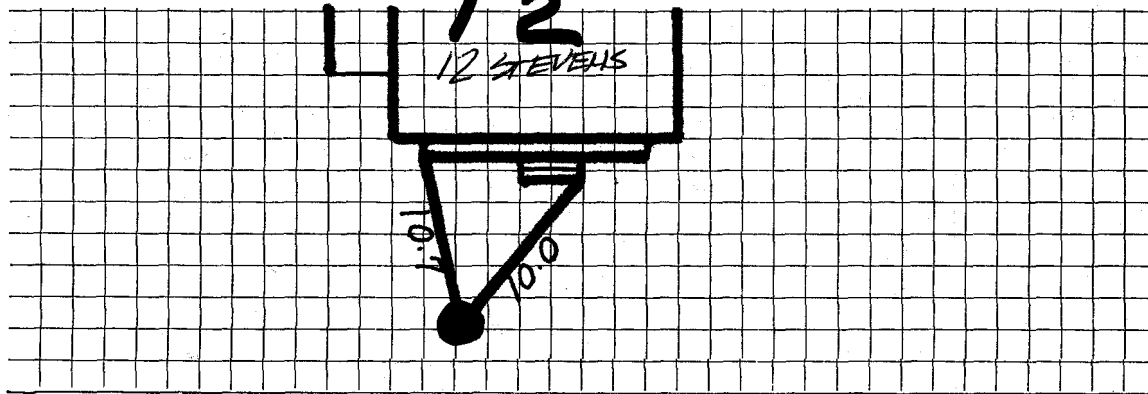

Connection made in _____ Street.

Work completed _____ 19

Remarks: