

Name

Ivar D. Johnson

Service No. ~~55~~ 486

Address

36 Fordham St., Arl.

5615

Location

Lot #35 ~~Carry Over~~ Stevens Road

Kind of Pipe

Size

Size of Main

~~Repairs-Renewals~~ - New Service

Location

| Date | Material | Amount | Total | Date | Amount |
|--------------------------------------|-----------------------|--------|-------|---------------|--------|
| 1936 | | | | | |
| April 3 | 2 hrs. labor @ 60¢ | 1 20 | | Oct. 24 35 | 13 50 |
| <i>Copy of Sept 16 40 to Russell</i> | 2 " " @ 55¢ | 1 10 | 2 30 | Aug. 19, 1936 | 2 90 |
| | 35 1" C.L. Pipe @ 27¢ | 9 45 | | | 16 40 |
| | 3 1" L.L. Coup. @ 18¢ | 54 | | | |
| | 1 1" L.L. Elbow | 45 | | | |
| | 1 1" Brass Nipple | 40 | | | |
| | 1 S. & W. | 1 75 | 14 09 | | |
| | | | 16 39 | | |
| | Say: \$16.40 | | | | |
| | Labor | | | | |

Deposited Cash

Billed 10/26

1/2" 1" Copper Curb to House

Checked 6-405 of CT 3/4 Copper Curb to Main

Hadley Press, Inc., Lexington

45
13.50

DATE Oct 24 1935

TOWN OF LEXINGTON—BOARD OF PUBLIC WORKS

WATER DIVISION

The undersigned applies for a supply of water at No. Lot # 35 Cary St. and hereby agrees to comply with the rules and regulations as now, or at any future time, established by the Board of Selectmen.

Am't. of Estimate \$ 13.50

Owner

Earl D Johnson


Am't. Paid \$ _____

Address

36 Fordham St.
Arlington

Builder _____

Sketch of Service Here

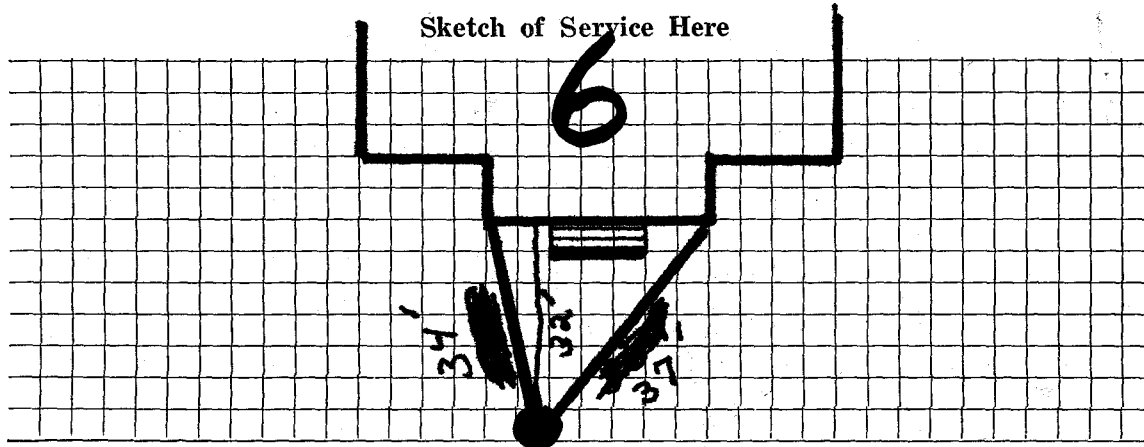

Connection made in _____ Street.

Work completed _____ 19

Remarks: