




DATE \_\_\_\_\_

TOWN OF LEXINGTON — BOARD OF PUBLIC WORKS  
WATER DIVISION

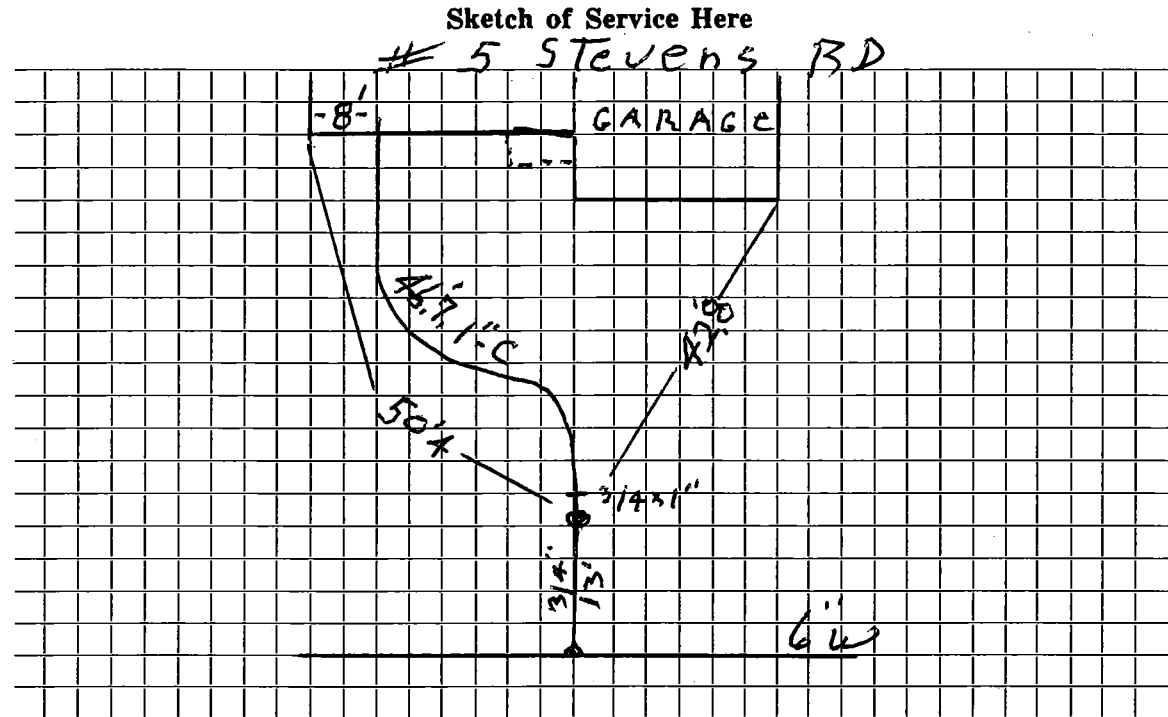

Connection made in..... Street.

Work completed 11/19/10 J-Mclau.....

Remarks:.....  
.....  
.....