

1183

Name Eben Johnson

Service No. ~~155~~ 487

Address 26 Prescott St., Arlington

Location 8 ~~CXGXXX~~, Stevens Road

Kind of Pipe

Size

Size of Main

Repair—Renewal—New Service

Location

Date
1941

Material

Amount

Total

Date

Amount

Nov. 8,

2 hrs. @ 60¢

1 20

Com. ^{1/27/41} ~~1/27/41~~

10% Overhead

12

1 32

74' 1" Copper tubing @ 22¢

16 28

1 1" C.x 3/4" I.S.& W.

2 50

1 1" C.Union (3 parts)

1 25

1 hr. trucking

75

22 10

November 4 1941

Deposited

25 00

Dec 30 1941

Refund

290

27 10

Labor

Hadley Press, Inc., Lexington

DATE 11.3.1941

TOWN OF LEXINGTON—BOARD OF PUBLIC WORKS

WATER DIVISION

The undersigned applies for a supply of water at No. 8 Cary St St. and hereby agrees to comply with the rules and regulations as now, or at any future time, established by the Board of Selectmen.

Am't. of Estimate \$ 2⁰⁰

Owner Oliver Johnson


Am't. Paid \$ _____

Address 26 Prescott St

Builder _____

Arlington

Sketch of Service Here

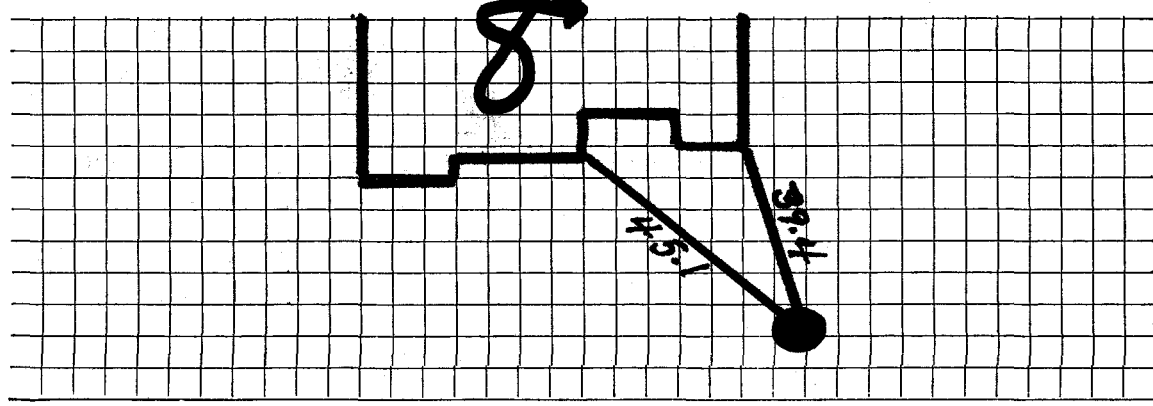

Connection made in _____ Street. Work completed _____ 19

Remarks: