

Name: ~~Virgil A. Jennings~~ ^{STEVENS}

Service No. 199

3419

Address 9 Gary Street

Location 9 Gary Street ~~Stevens Road~~

Kind of Pipe

Size

Size of Main

~~Repair~~ ~~Renewal~~ ~~New Service~~

Com 12/31/47

Location

Date	Material	Amount	Total	Date	Amount
Oct. 16, '47	Labor	1 05	1 05	April 14 '48	12 86
	10% Overhead		11		
	30' - 3/4" Copper Tubing @.26	7 80			Non-Charge
	1 - 3/4" C x 1/2" I.W.H. S & W	3 15		Oct. 16, '47	Labor 1 05
	Truck ng 1 hr. @.75	75		22' - 3/4" Copper Tubing @.26	5 72
4-29-'68	Repair		12 86	1 - 3/4" C Corp-cock	3 00
	1' 3/4" Copper			1 - 3/4" C x 3/4" C Curb-cock	3 68
	2 3/4" C. 3 Part UNION			1 - Box & Rod	4 26
				1 - 1/2" Straight Tail Piece	30
4-16-'03	Repair made 4' inside of curb			1 - 1/2" Offset Tail Piece	30
	Labor			Truck ng 1 hr. @.75	75
	2-3/4" 3pt unions				19 06
	2'-3/4" copper				

Bill sent 1/8/48

TOWN OF LEXINGTON – BOARD OF PUBLIC WORKS

WATER DIVISION

The undersigned applies for a supply of water at No..... St. and hereby agrees to comply with the rules and regulations as now, or at any future time, established by the Board of Selectmen.

Am't of Estimate \$.....

Owner


Am't Paid \$.....

Address

Builder

.....

Sketch of Service Here

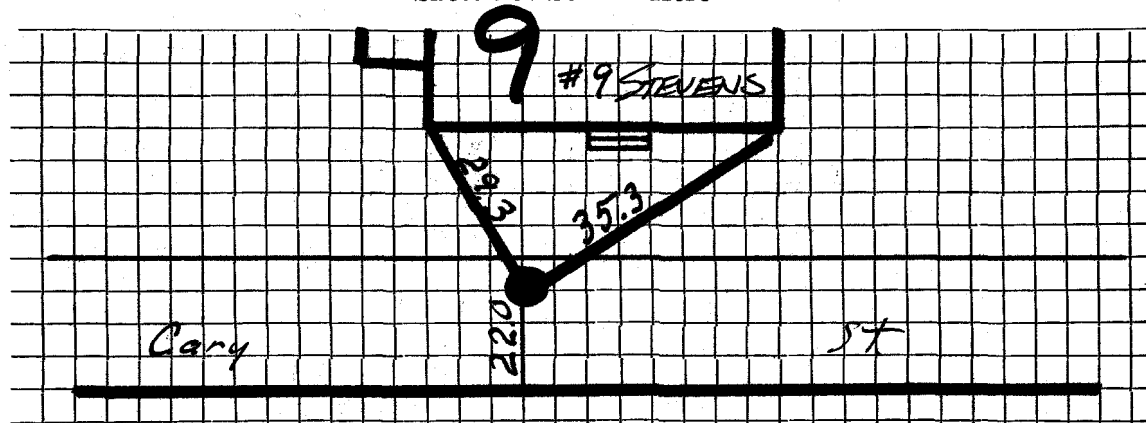

Connection made in Street.

Work completed19

Remarks: