

WATER SERVICE RECORD

#5673

Name John F. Cahill

Service No. 118

Address 17 Stimson Ave.

#6967

Location


~~Repairs/Repair~~ - New Service

Date	Material	Amount	Total	Date	Amount
5/29/56	Labor	1 95		5-29-56	Deposit \$10 00
	10% overhead	20	2 15	8-6-56	Refund \$2 14
	1 - 3/4Cx $\frac{1}{2}$ I.W.H. Stop & Waste		4 96		NON CHARGE \$7 86
	1 hr. trucking	"	75	5/29/56	Labor 1 95
			7 86		
				30' - 3/4" Copper tubing @ .4850	14 55
				1 - 3/4" C. Union (3 parts)	2 27
				1 - 3/4" C. Corp Cock	4 34
	Owner supplied copper			1 - 3/4" C. Curb Cock	5 94
				1 Box & Rod	4 62
				1 - $\frac{1}{2}$ " Straight tailpiece	50
				1 - $\frac{1}{2}$ " Offset tailpiece	50
					<u>34.67</u>

DATE _____

TOWN OF LEXINGTON — BOARD OF PUBLIC WORKS
WATER DIVISION

Sketch of Service Here

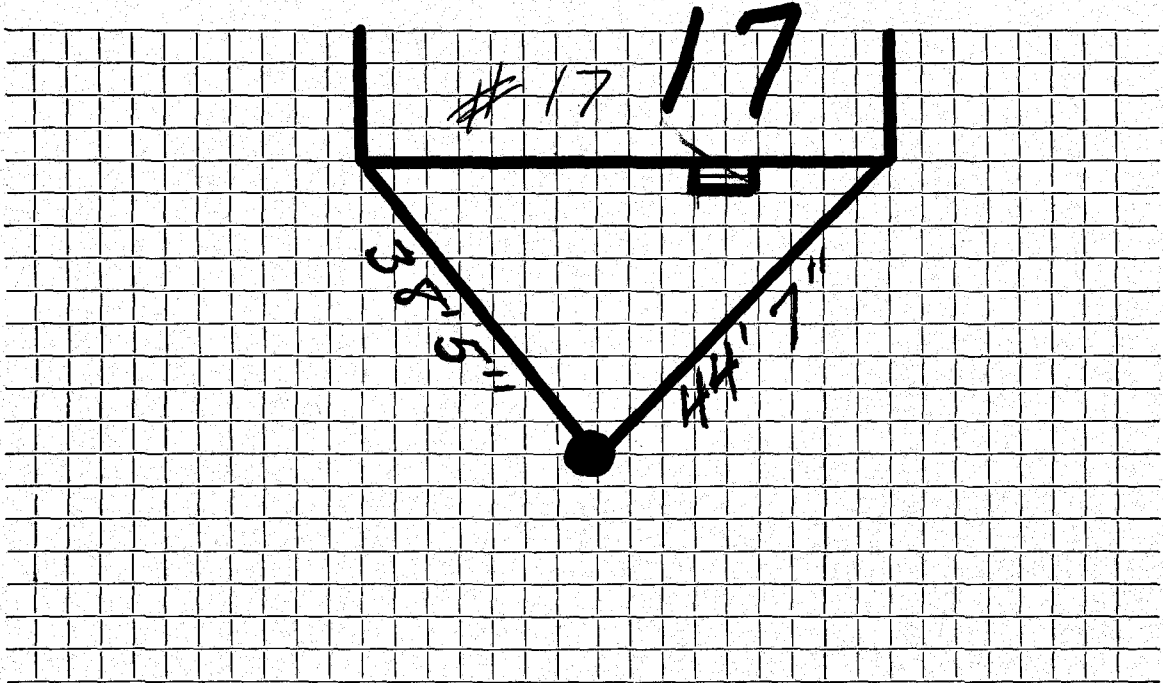

Connection made in Street. Work completed

Remarks:
.....
.....