




DATE 7/10/2017

TOWN OF LEXINGTON — BOARD OF PUBLIC WORKS

WATER DIVISION

Sketch of Service Here

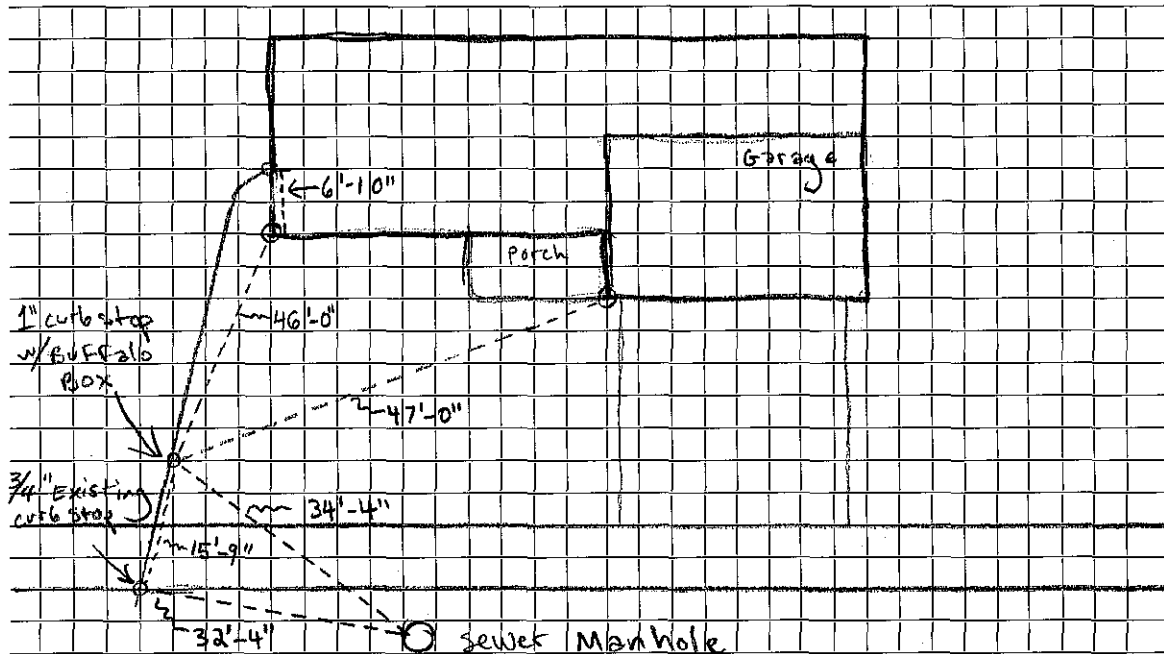

Connection made in 18 Stinson Avenue Street. Work completed .....

Remarks: .....