

WATER SERVICE RECORD

Name John Cahill

Service No. 64

Address 22 Stimpson Ave.

Location Lexington

~~Repair/~~Renewal—New Service

Comm. 10-28-57


| Date | Material | Amount | Total | Date | Amount |
|--------|---------------------------------|--------|-------|----------|-----------------------------------|
| 4/1/57 | labor | 2 04 | | 4-11-57 | Deposit \$ 10 00 |
| | 10% overhead | 20 | | 10-28-57 | Refund 2 05 |
| | | | 2 24 | | \$ 7 95 |
| | Owner's copper | | | | <u>NON*CHARGE</u> |
| | 1 3/4" C x 1/2 IWH stop & waste | | 4 96 | 4/1/57 | Labor 2 04 |
| | 1 hr trucking | | 75 | 4-13-57 | 15' 3/4" cop. tubing @ .4228 6 34 |
| | | | 7 95 | | 1 3/4" C. Corp Cock 5 94 |
| | | | | | 1 3/4" C Curb Cock 4 64 |
| | | | | | 1 Box & Rod 4 62 |
| | | | | | 1 #St. tail piece 50 |
| | | | | | 1 #offset tail piece 50 |
| | | | | | 24 58 |

DATE _____

TOWN OF LEXINGTON — BOARD OF PUBLIC WORKS

WATER DIVISION

Sketch of Service Here

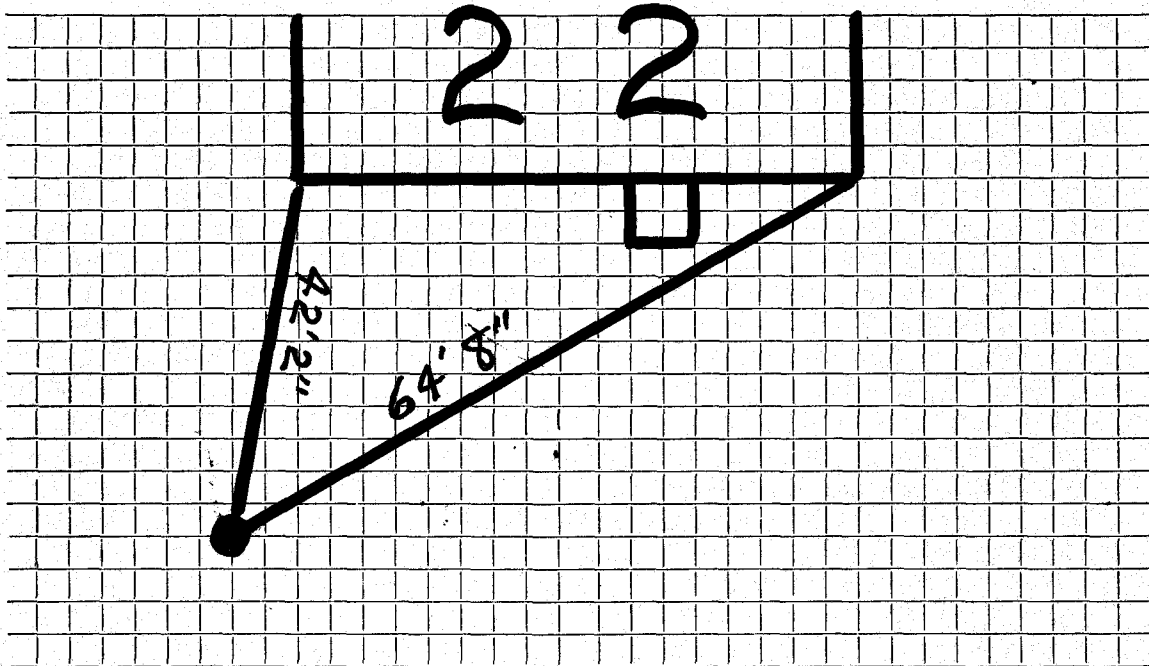

Connection made in Street. Work completed

Remarks:

.....

.....