

#8747

#5905

## WATER SERVICE RECORD

Name John F. Cahill

Service No. 120

Address ~~23~~ Stimson Ave.

Location 23

~~Repair - Renewal~~ - New Service


Date	Material	Amount	Total	Date	Amount
5/29/56	Labor	1 95		5-29-56	Deposit \$1000
	10% overhead	20	2 15	8-6-56	Refund 214
	1 - 3/4 Cx 1/2 I.W.H. Stop & Waste		4 96		NON CHARGE #786
	1 hr. trucking		75	5/29/56	Labor 1 95
			7 86	30' - 3/4" Copper tubing @ .4850	14 55
				1 - 3/4" C. Corp Cock	4 34
	Owner supplied copper			1 - 3/4" C. Curb Cock	5 94
				1 Box & Rod	4 62
				1 - 1/2" Straight tailpiece	50
				1 - 1/2" Offset tailpiece	50
					32 40

DATE \_\_\_\_\_

TOWN OF LEXINGTON — BOARD OF PUBLIC WORKS

WATER DIVISION

Sketch of Service Here

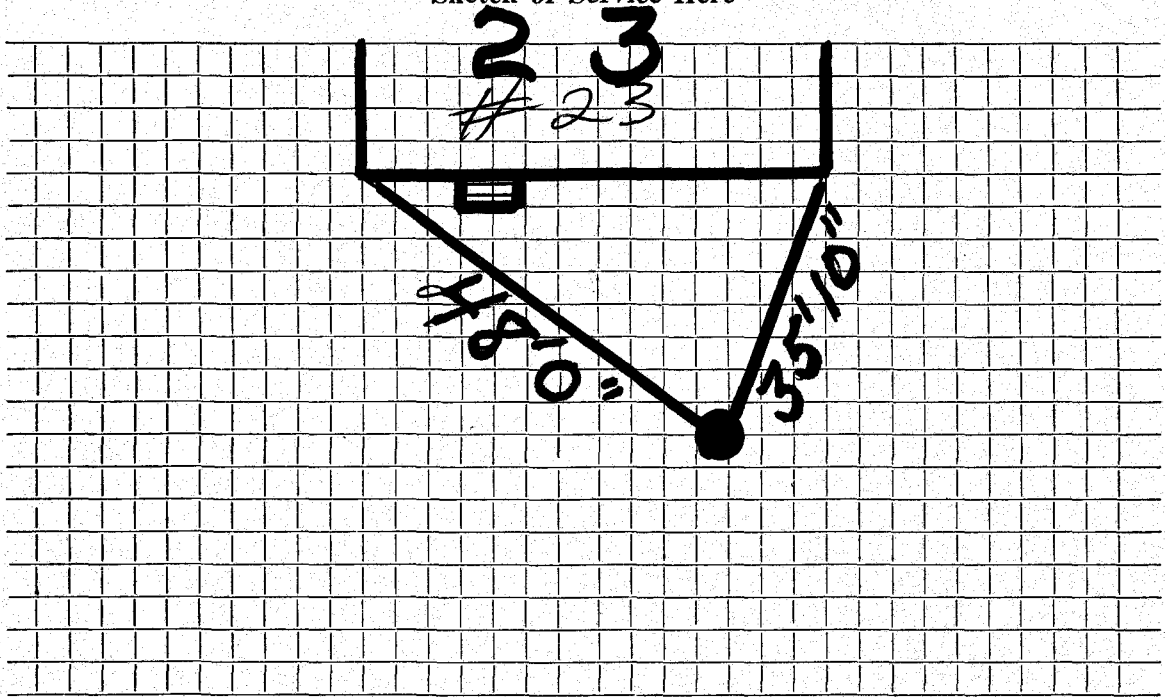

Connection made in ..... Street. Work completed .....

Remarks: .....  
.....  
.....