

WATER SERVICE RECORD

Name John Cahill

Service No. 65

4750

Address 24 Stimpson Road

6906

Location Lexington, Mass.

~~Repair-Renewal~~ New Service

Comm. 10-28-57


Date	Material	Amount	Total	Date	Amount	
4/1/57	labor	2 04		4-11-57	Deposit	10 00
	10% overhead	20		10-28-57	Refund	2 05
			2 24			# 7 95
	owner's copper				<u>NON-CHARGE</u>	
	1 3/4" C x 1/2 IWH stop & waste		4 96	4-1-57	labor	2 04
	1 hr trucking @ .75		75		15' 3/4" copper tubing @ .4228	6 34
			7 95		1 3/4" C. Corp Cock	5 94
					1 3/4" C. Curb Cock	4 64
					1 box & rod	4 62
					1 1/2 st. tail pc.	50
					1 1/2 offset pail pc.	50
						24 58

DATE _____

TOWN OF LEXINGTON — BOARD OF PUBLIC WORKS

WATER DIVISION

Sketch of Service Here

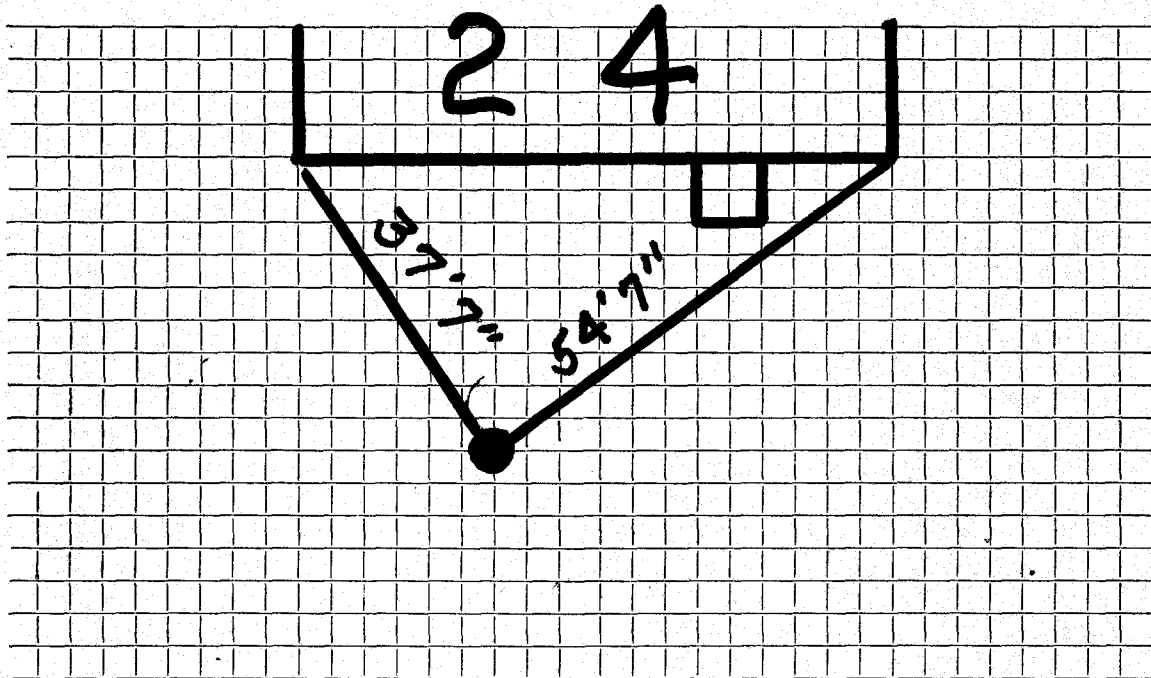

Connection made in Street. Work completed

Remarks:

.....

.....