

WATER SERVICE RECORD

F12535

Name John F. Cahill

Service No. 124

Address 30 Stimson Ave.

Location


~~Repair~~ ~~Renewal~~ - New Service

Date	Material	Amount	Total	Date	Amount
6/19/56	Labor	1 95		5-29-56	Paid Deposit \$ 10 00
	10% overhead	20	2 15	8-6-56	Refund 2 14
	1 - 3/4" Gx 1/2" I.W.H. Stop & Waste		4 96		NON CHARGE \$ 7 86
	1 hr. trucking		75	6/19/56	Labor 1 95
			7 86	12' - 3/4" Copper tubing @ .4850	5 82
				1 - 3/4" C. Corp Cock	4 34
	Owner supplied copper			1 - 3/4" C. Curb Cock	5 94
				1 Box & Rod	4 62
				1 - 1/2" Straight tailpiece	50
				1 - 1/2" Offset tailpiece	50
					<u>23 67</u>

DATE _____

TOWN OF LEXINGTON — BOARD OF PUBLIC WORKS
WATER DIVISION

Sketch of Service Here

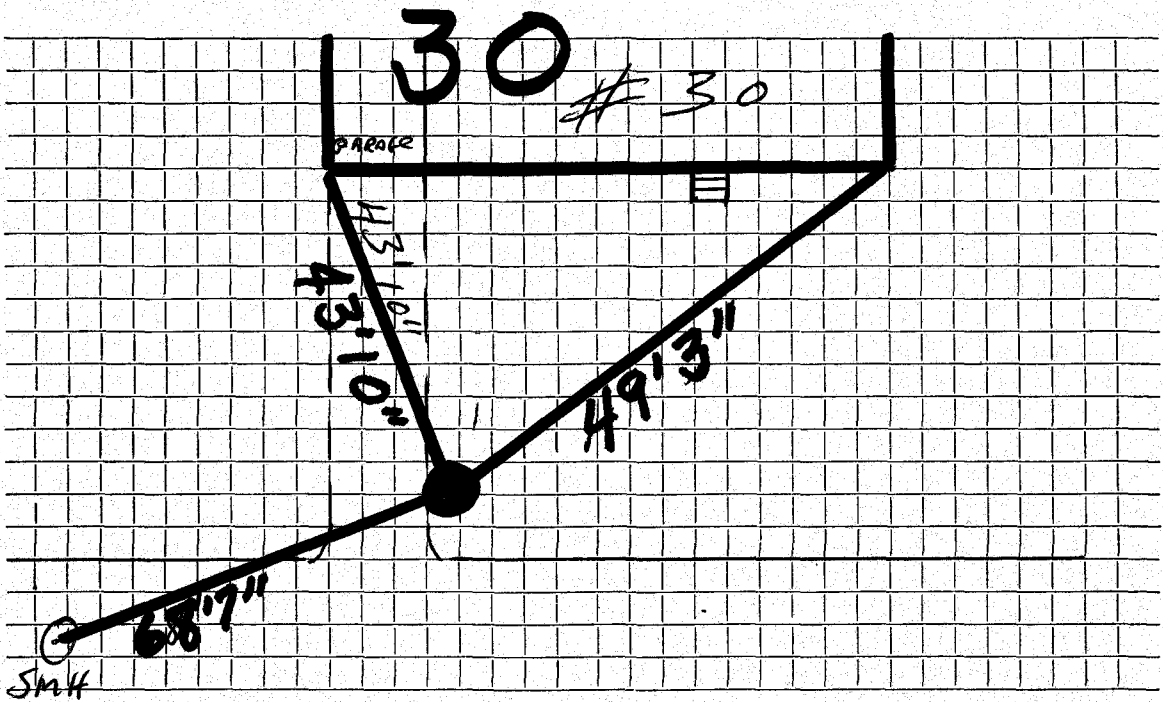

Connection made in Street. Work completed

Remarks:
.....
.....