

## WATER SERVICE RECORD

Name John Cahill

Service No. 257

Address 33 Stimson ~~Ave~~

Location

~~Repair - Renewal~~ - New Service

Comm. 10-8-56


Date	Material	Amount	Total	Date	Amount
9 / 56	Labor	1 95		8-21-56 Deposit	10 00
	10% Overhead	20	2 15	10-8-56 Paid by Refund on W.H.C. 255	13
	Owner's Copper			NOM CHARGE	10 13
	1 3/4" C 3 part Union		2 27	Labor	1 95
	1 3/4" x 1/2" I.W.H.S TOP & Waste		4 96	27' 3/4" Copper tubing @ .4850	13 10
	1 hr. trucking @ .75		10 75	1 3/4" C Corp Cock	4 64
			10 13	1 3/4" C Curb "	5 94
				1 1/2" Straight Tail Piece	50
				1 1/2" Offset " "	50
				1 Box & Rod	4 62
					31 25

DATE \_\_\_\_\_

TOWN OF LEXINGTON — BOARD OF PUBLIC WORKS

WATER DIVISION

Sketch of Service Here

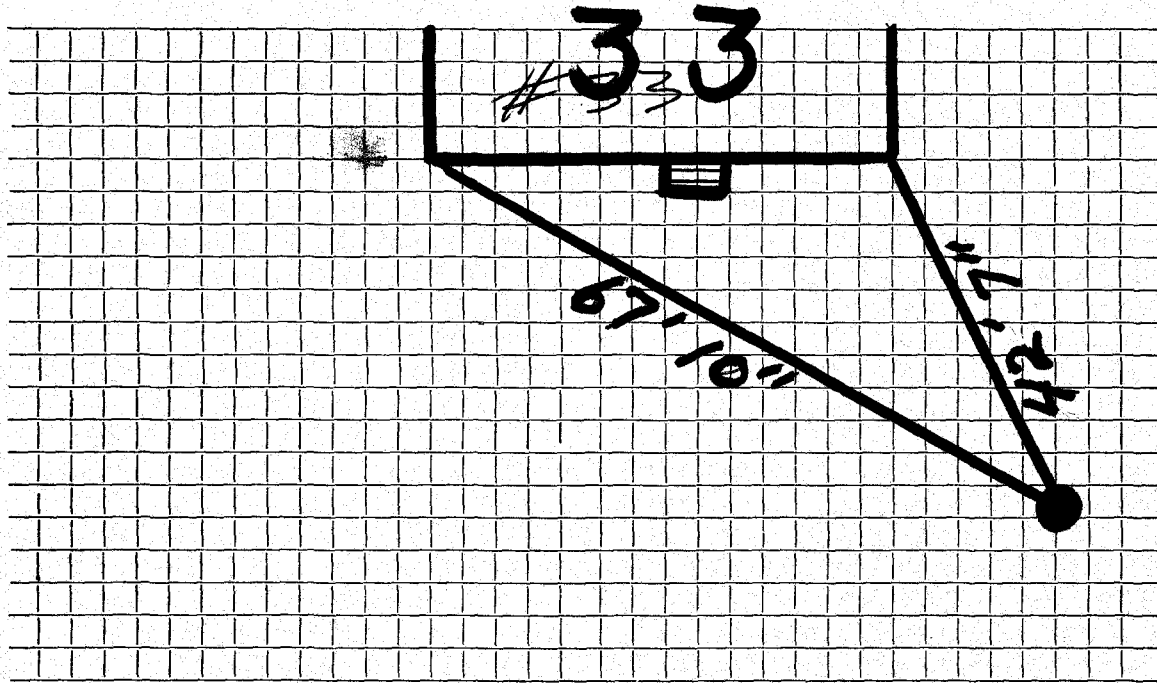

Connection made in ..... Street. Work completed .....

Remarks: .....  
.....  
.....