

## WATER SERVICE RECORD

Name R.D. Hamilton Constr. Inc.

Service No. 42

Address ~~9-11-11-11-11 Road~~ (Changed to 34 Stimson Avenue) May 29

Location

~~Repair - Repair~~ - New Service

WO# 8706


JUN 29 1964

Date	Material	Amount	Total	Date	Amount
5/21/64	Labor	2 42		4-17-64	50 00
	10% O.H.	24	2 66	4-29-64	18 79
	54' 6" Transite Pipe @ .42		22 68		31 51
	1 3/4" Cx 1/2 I.W.H. Stop & Waste		6 17		
			31 51	5/21/64	2 31
					6' 3/4" Copper Tubing @ .42
					2 52
					1 3/4" C Corp Cock
					4 91
					1 3/4" C Curb Cock
					6 28
					1 1/2 Straight Tailpiece
					50
					1 1/2 Offset Tailpiece
					50
					17 02

DATE \_\_\_\_\_

TOWN OF LEXINGTON — BOARD OF PUBLIC WORKS  
WATER DIVISION

Sketch of Service Here

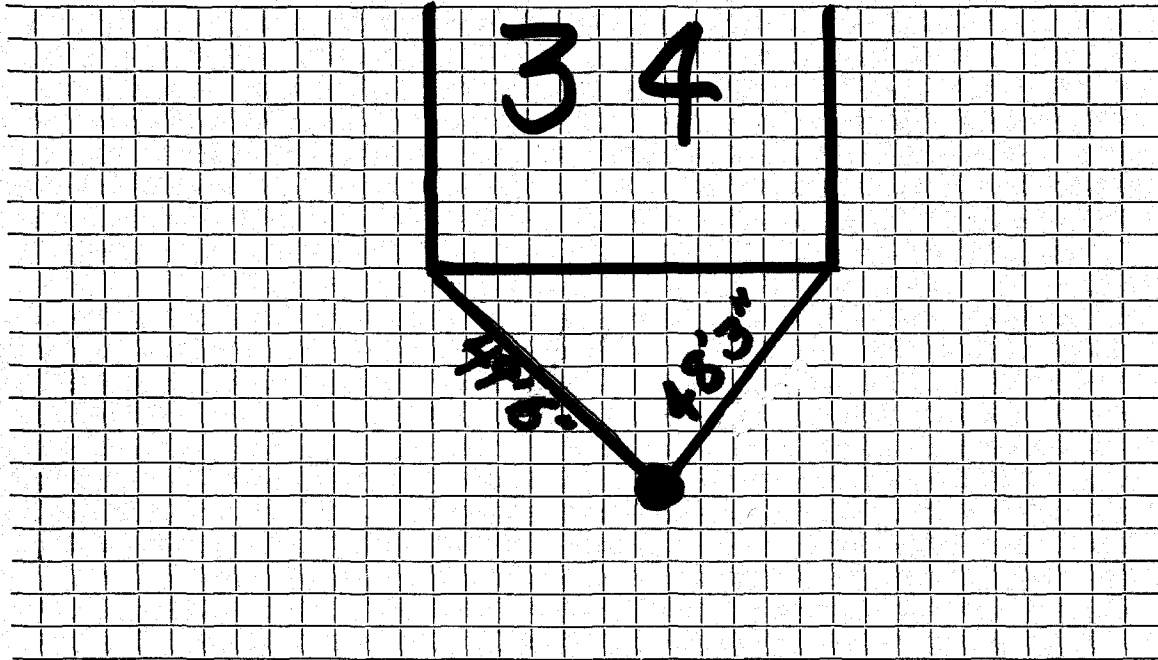

Connection made in ..... Street.      Work completed .....

Remarks: .....

.....

.....