

WATER SERVICE RECORD

5500

Name Oge Norman Johnson

Service No.

70

Address 8 Stimson Avenue

Location John Grant Permit #49

~~Revised Estimate~~ - New Service W.O. #8916


DEC 28 1964

Date	Material	Amount	Total	Date	Amount
7-21-64	Labor	4 73		7-18-64	25 00
	10% O.H.	47	5 20		
	11' 3/4" Copper tubing @.42		4 62		
	1 3/4" Corp Cock		6 28		
	1 3/4" Curb Cock		4 00		
	1 Box & Rod		4 90		
			25 00		
7-23-64	40' 3/4" Copper tubing				

TOWN OF LEXINGTON — BOARD OF PUBLIC WORKS

WATER DIVISION

Sketch of Service Here

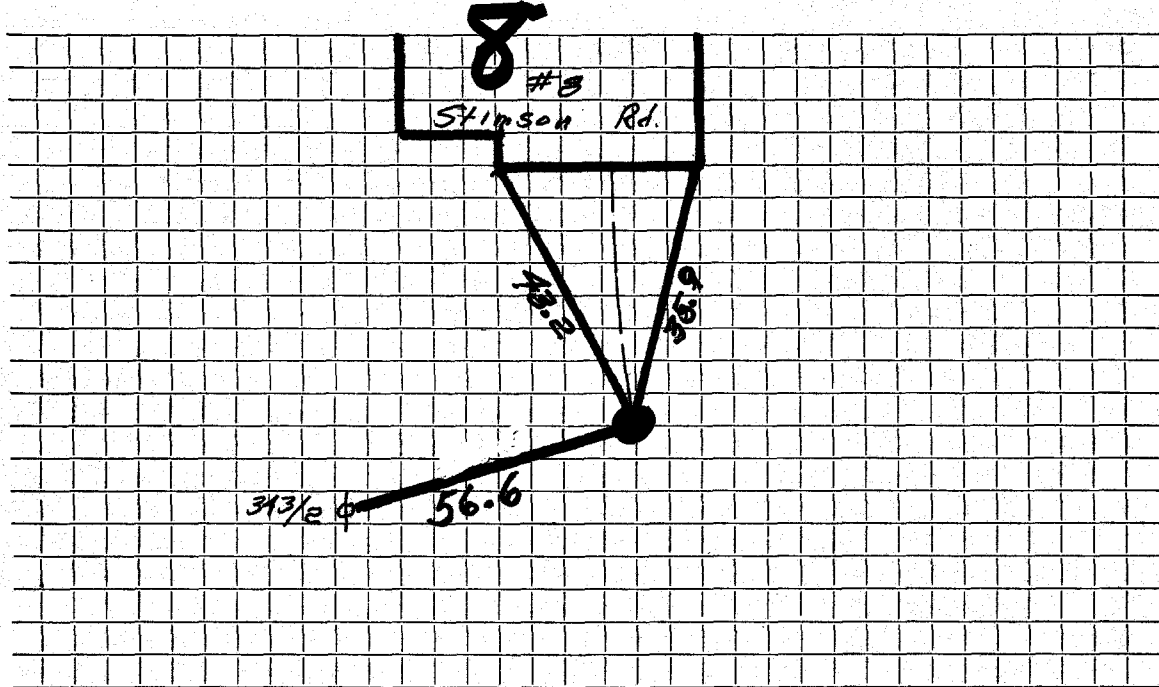

Connection made in Street. Work completed

Remarks:
.....
.....