

WATER SERVICE RECORD

Name Moore Const. Co.

Service No. 110

Address 3 Stonewall Road

Location

552 # 665

~~Repair~~ ~~Renewal~~ New Service

Cam. 7-18-55


Date	Material	Amount	Total	Date	Amount
5/26/55	Labor	17 25		4-27-55	Deposited 125 00
	10% overhead	1 73	18 98	7-18-55	Refunded * (10 47
	135' - 3/4" copper tubing @	3693-49	86		<u>NON CHARGE</u> 114 53
	1 - 3/4" C x 1/2" I.W.H. stop & waste	4 00			SERVICE WAS IN TO CURB:
	2 - 3/4" C. unions @ 1.72	3 44		1 - 1/2 straight tail piece	50
	5 hrs. Littlefield shovel @ 7.50	37 50		1 - 1/2 offset tail piece	50
	1 hr. trucking		75	8-7-53	1 00
			<u>114 53</u>		
				24' 3/4" Copper	
				1 3/4" C. Corp Cock	
				1 3/4" C. X 3/4" C. Curb Cock	
				1 Box + Rod	
				* \$2.00 made payable to town to apply on bill due on W.A.C. # 111	

DATE _____

TOWN OF LEXINGTON — BOARD OF PUBLIC WORKS

WATER DIVISION

Sketch of Service Here

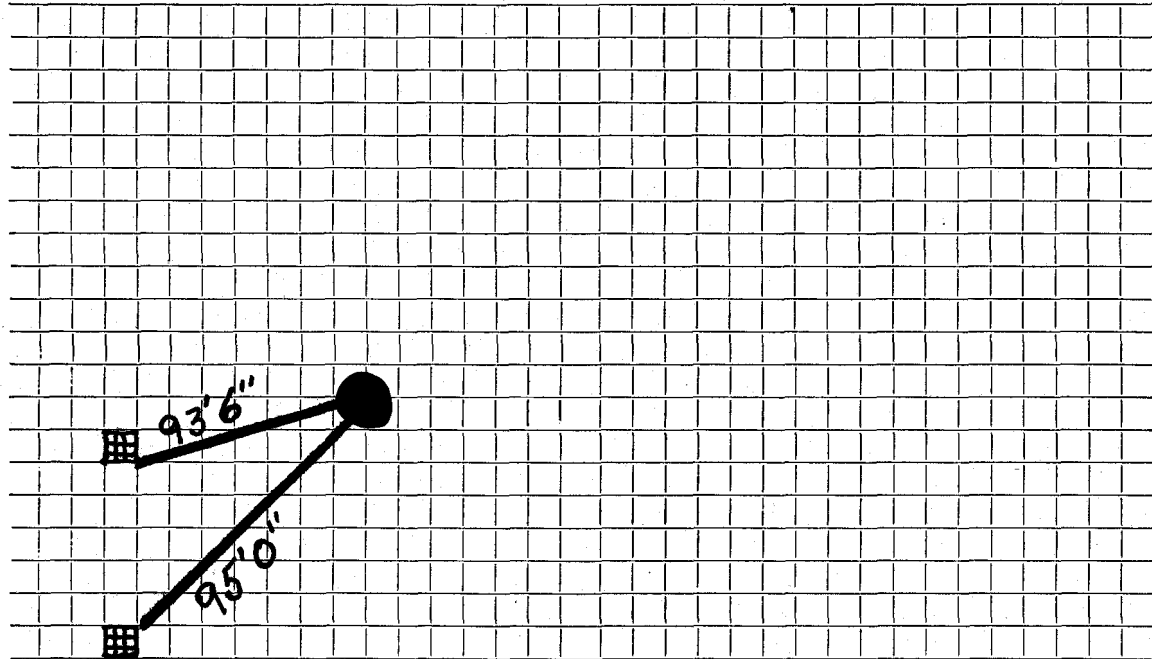

Connection made in Street. Work completed

Remarks:

.....

.....