

WATER SERVICE RECORD

3720

Service No. 386

Name Chester Nagel

Address 4 Stonewall Road

Location

~~Repair & Renewal~~ - New Service

Conn. 12-31-55


Date	Material	Amount	Total	Date	Amount
12/3/55	Labor	19 95		12-2-55	Deposited \$ 75 00
	10% Overhead	2 00	21 95	1-16-56	Paid <u>32 32</u>
	90' 3/4" Copper tubing @ .56		50 40		NON CHARGE 107 32
	1- 3/4Cx1/2 I.W.H. Stop & Waste		4 00		1 - 1/2" straight tail piece 50
	1- 3/4C Union (3 parts)		1 72		1 - 1/2" offset tail piece <u>50</u>
	3 hrs. Littlefield Shovel @ 9.50		28 50	8-6-53	1 00
	1 hr. trucking		75		11' 3/4" Copper
			107 32		1 3/4"C. Corp Cock
					SERVICE WAS IN TO CURB
					1 3/4"C X 3/4"C. Curb Cock
					1 Box + Rod
					Bill sent 1-10-56

DATE _____

TOWN OF LEXINGTON — BOARD OF PUBLIC WORKS

WATER DIVISION

Sketch of Service Here

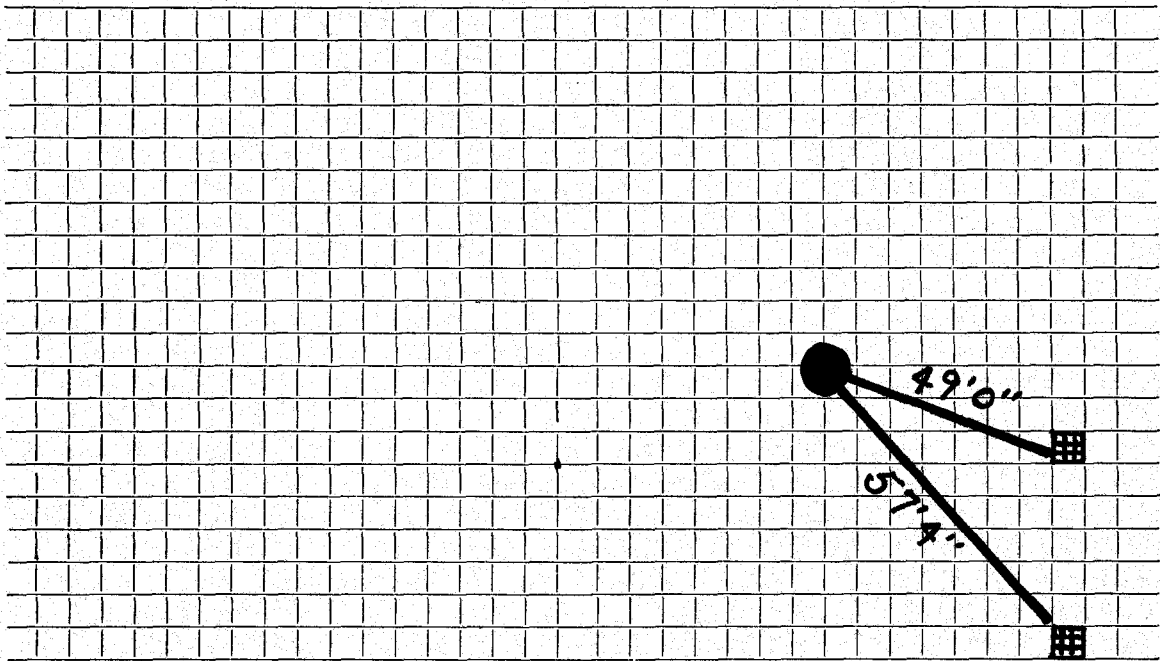

Connection made in Street. Work completed

Remarks:
.....
.....