

WATER SERVICE RECORD

Name

Service No.

Address 5 Stonewall Rd. lot #21

Location

Repair/Replacement—New Service SERVICE IN TO CURB


Date	Material	Amount	Total	Date	Amount
5/24/55	80' 3/4" Copper				
	1 3/4" 1/2 S + Waste				
	1 3/4" Union				
				8/6/53	
					NON CHARGE
					Labor
					16 95
					80' - 3/4" Copper tubing@.3629
					29 03
					1 3/4" C. corp-cock
					4 33
					1 3/4" C x 3/4" C. curb-cock
					4 67
					1 3/4" C x 3/4" C. Union 3 pts.
					1 72
					1 box and rod
					3 90
					1 hr. trucking
					75
					61 35

DATE \_\_\_\_\_

TOWN OF LEXINGTON — BOARD OF PUBLIC WORKS

WATER DIVISION

Sketch of Service Here

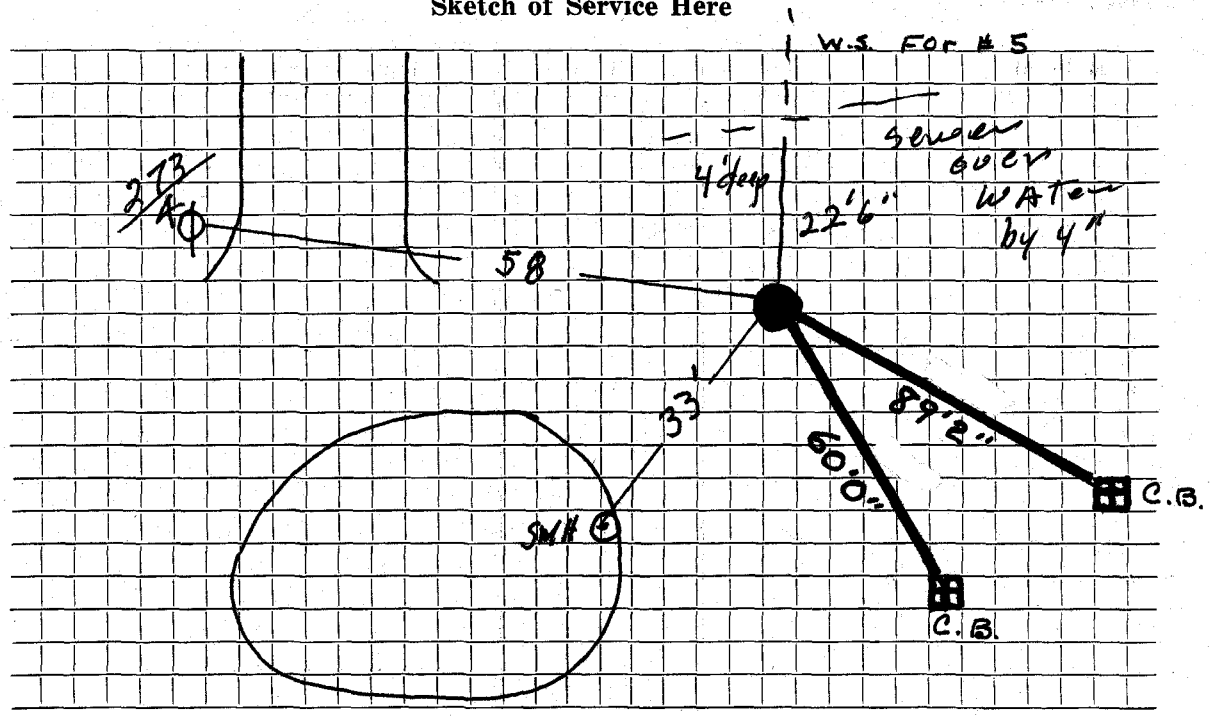

Connection made in ..... Street. Work completed .....

Remarks: .....  
.....  
.....