

WATER SERVICE RECORD

Name Arthur M. Randall

Service No. 177

Address 6 Stonewall Rd. lot #20

Location

Remarks ~~Renewal~~ - New Service SERVICE IN TO CURB

Comm 11-30-59

Date	Material	Amount	Total	Date	Amount
9-25-59	Labor	7 75		8-10-59	Deposit 100 00
	10% O. H.	78	8 53	11-30-59	Returned 33 05
	72' 3/4" Copper tubing @.41		29 52		NON CHARGE 46 95
	1 3/4" C x 1/2 I.W.H. Stop & Waste	5	88	8/6/53	Labor 13 95
	1 3/4" C 3 part Union		2 27	60' - 3/4" Copper tubing@.3629	21 77
	1 Hr. Trucking @.75		75	1- 3/4" C. corp-cock	4 33
			46 95	1 - 3/4" C x 3/4" C . curb-cock	4 67
				1 box and rod	3 90
				1 hr. trucking	75
					49 37
				9-25-59 1 1/2 Straight Tailpiece	50
				1 1/2 Offset Tailpiece	50
					50 37


DATE _____

TOWN OF LEXINGTON — BOARD OF PUBLIC WORKS

WATER DIVISION

Sketch of Service Here

W.S. For # 6

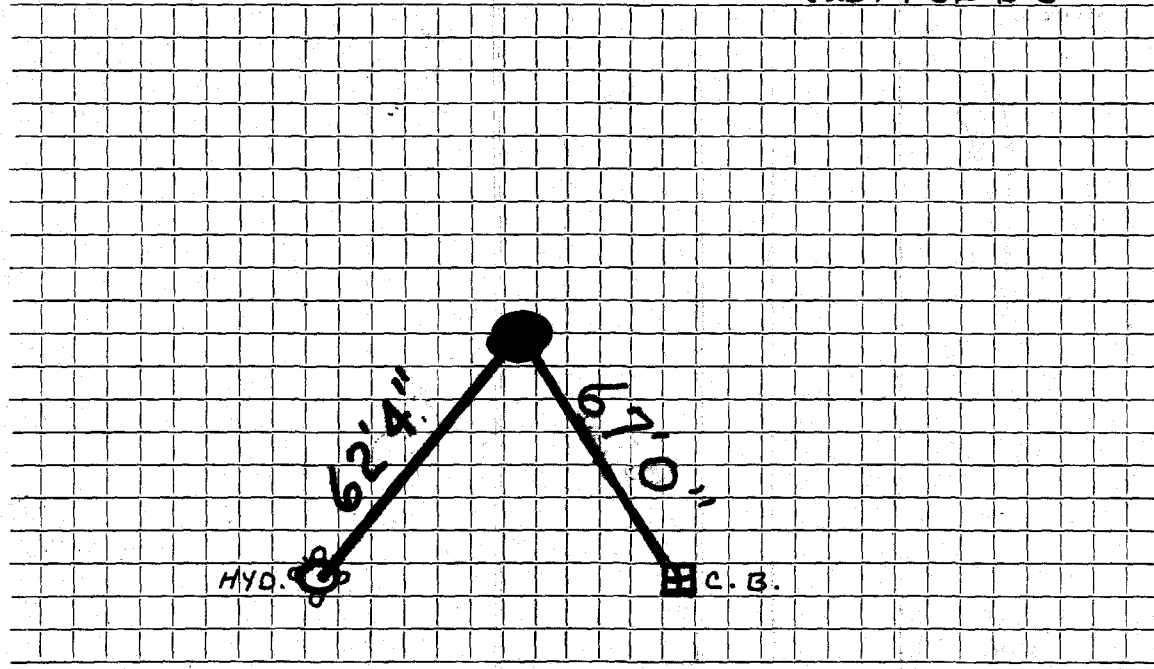

Connection made in Street. Work completed

Remarks:

.....

.....