


DATE _____

TOWN OF LEXINGTON — BOARD OF PUBLIC WORKS
WATER DIVISION

Sketch of Service Here

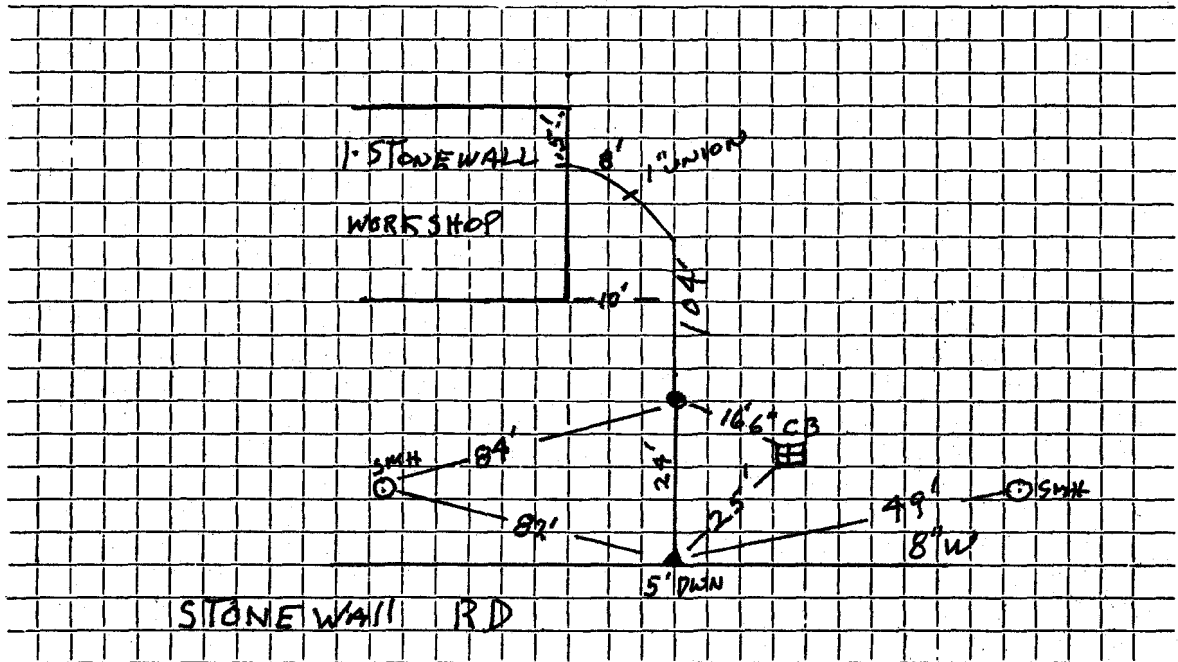

Connection made in STONEWALL Street. Work completed 8/98

Remarks:

.....

.....