


DATE July 1983

TOWN OF LEXINGTON — BOARD OF PUBLIC WORKS

WATER DIVISION

Sketch of Service Here

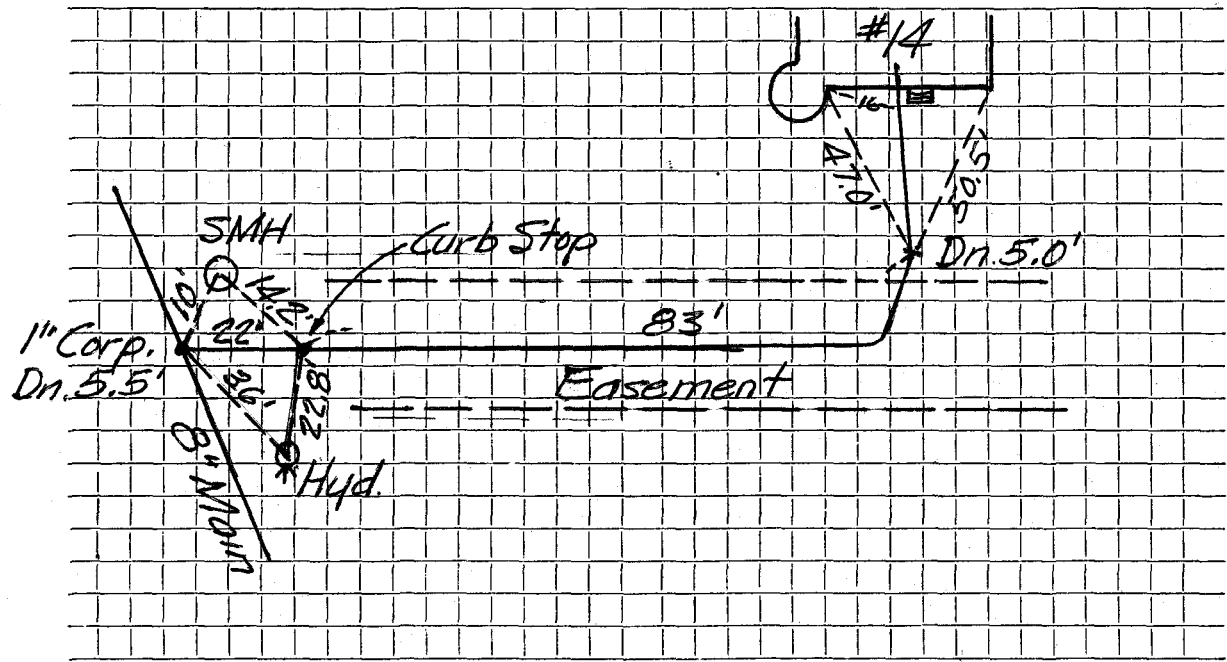

Connection made in Easement ~~Street~~ Work completed Oct. 10, 1983

Remarks:

.....

.....