


7-13-83

DATE ~~12/24/96~~

TOWN OF LEXINGTON — BOARD OF PUBLIC WORKS

WATER DIVISION

Sketch of Service Here

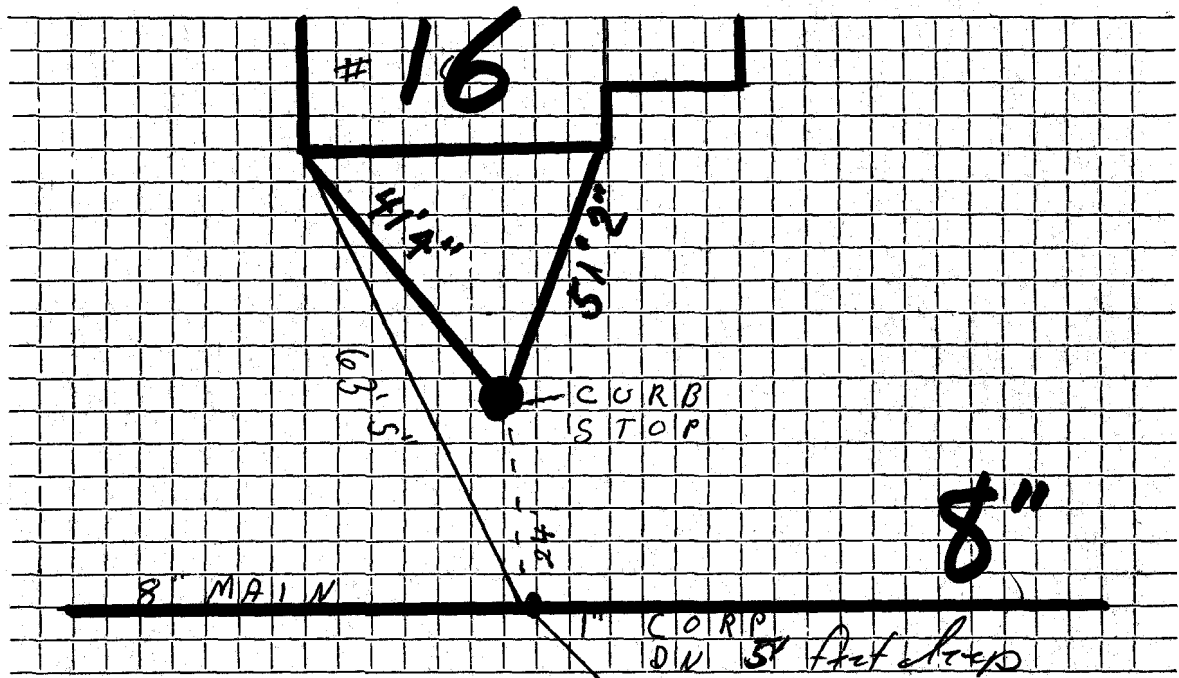

Connection made in Street. 24' Work completed

Remarks: *Iron inside 1"* *OSMH*