


TOWN OF LEXINGTON — BOARD OF PUBLIC WORKS

WATER DIVISION

Sketch of Service Here

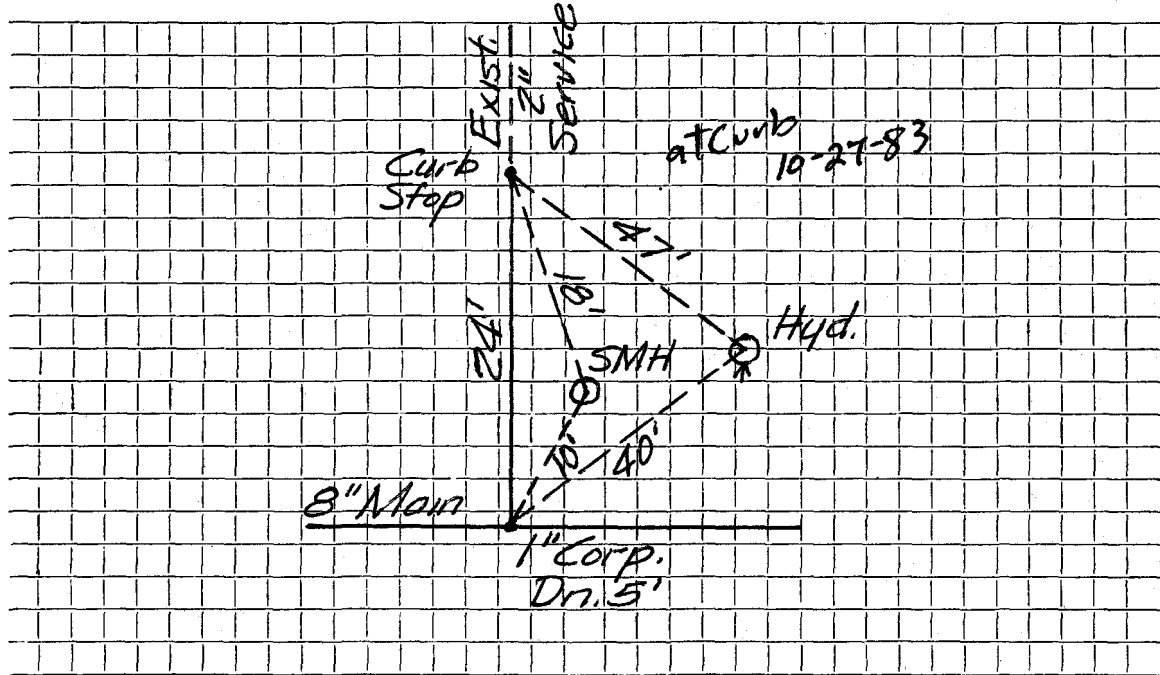


Connection made in *Stratham Rd.* Street. Work completed

Remarks: *This is a temporary common service to #18 & #14,*
cross-referenced shut at Curb 10-27-83

TOWN OF LEXINGTON — BOARD OF PUBLIC WORKS
WATER DIVISION

Sketch of Service Here

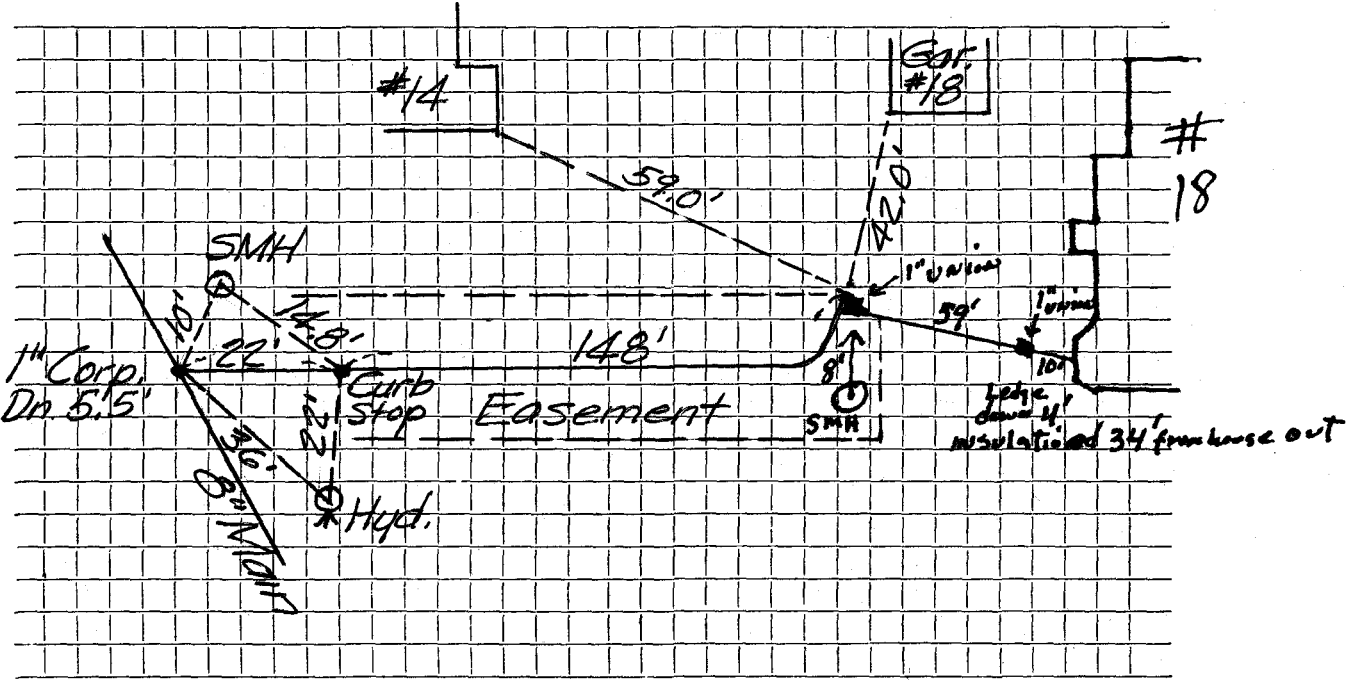

Connection made in Easement ~~Street~~ Work completed

Remarks: Same travel as sewer right of sewer

.....

.....