


DATE _____

TOWN OF LEXINGTON — BOARD OF PUBLIC WORKS

WATER DIVISION

Sketch of Service Here

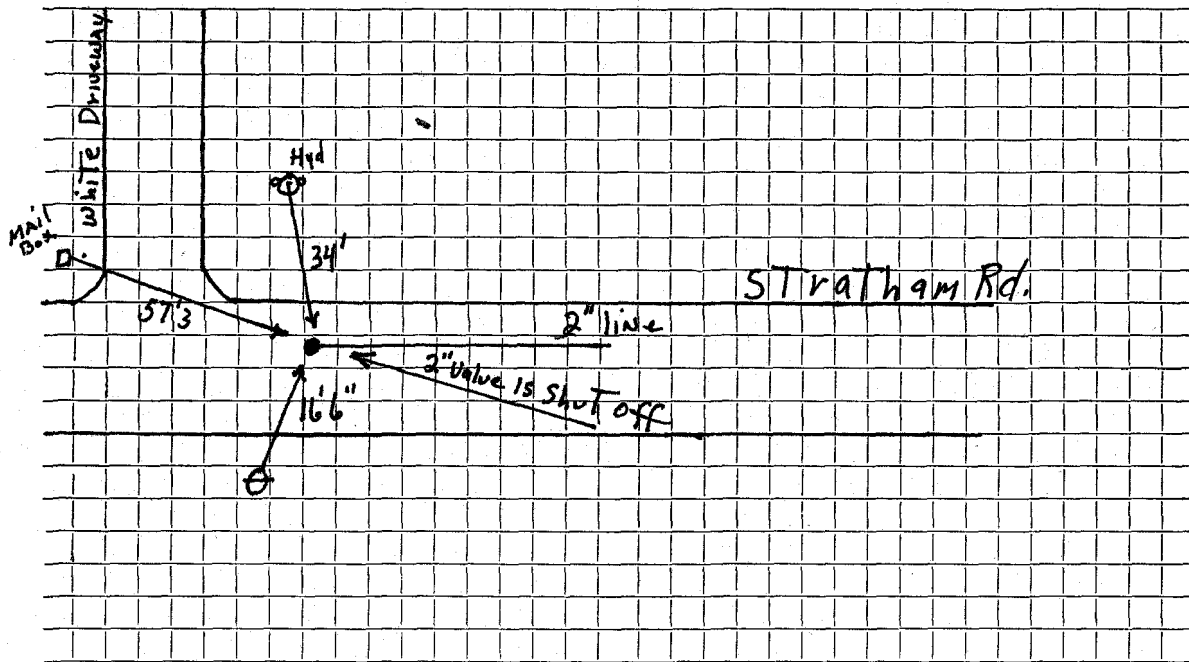

Connection made in Street. Work completed

Remarks:


.....
.....

DATE 10-19-90

TOWN OF LEXINGTON — BOARD OF PUBLIC WORKS

WATER DIVISION

Sketch of Service Here

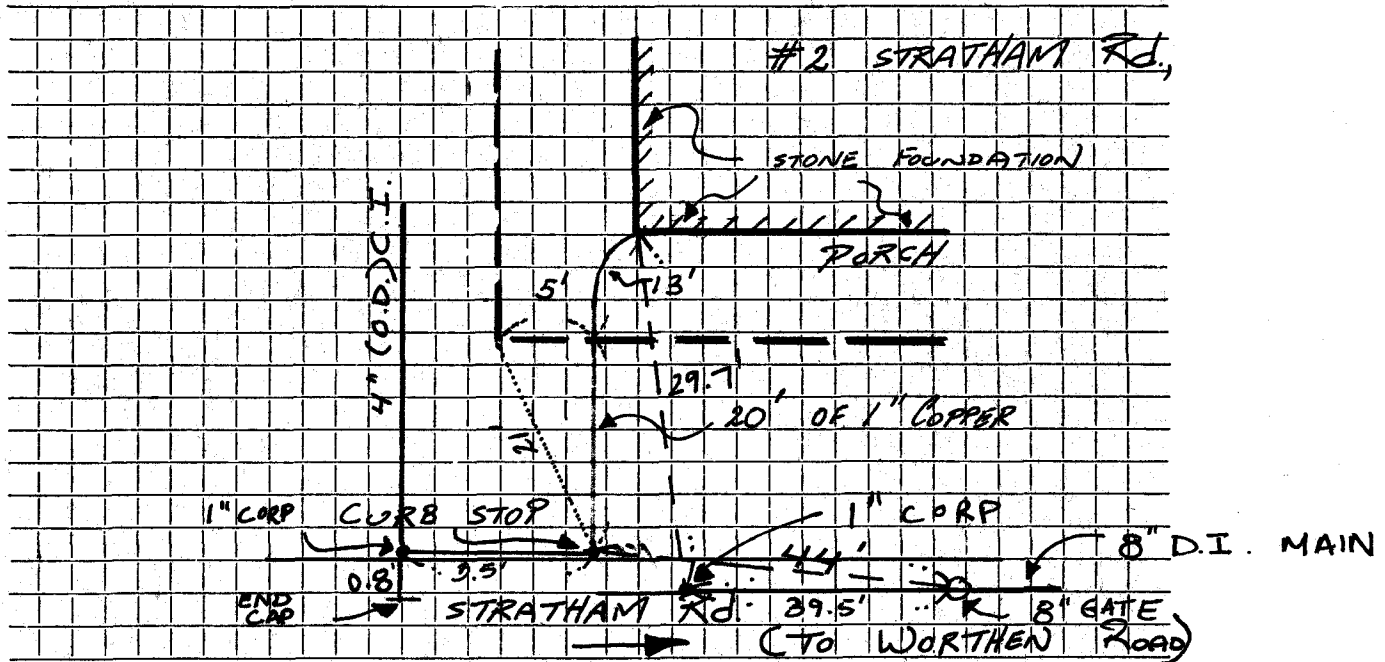

Connection made in STRATHAM Street. Work completed

Remarks: INSPECTED 10-11-90, BY P. BARROWS. CONSTRUCTION BY ARLEX OIL