




DATE \_\_\_\_\_

TOWN OF LEXINGTON — BOARD OF PUBLIC WORKS

WATER DIVISION

Sketch of Service Here

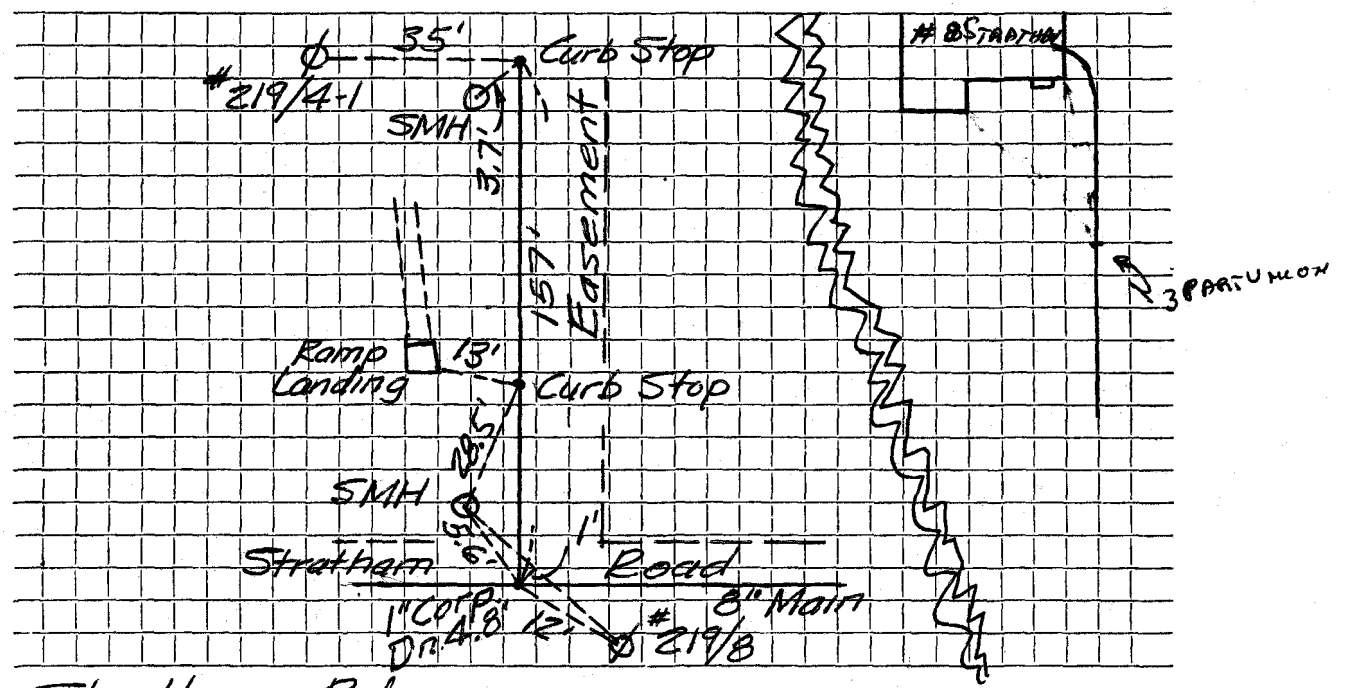

Connection made in Stratham Rd. Street. Work completed .....

Remarks: .....

.....

.....




DATE \_\_\_\_\_

TOWN OF LEXINGTON — BOARD OF PUBLIC WORKS

WATER DIVISION

Sketch of Service Here

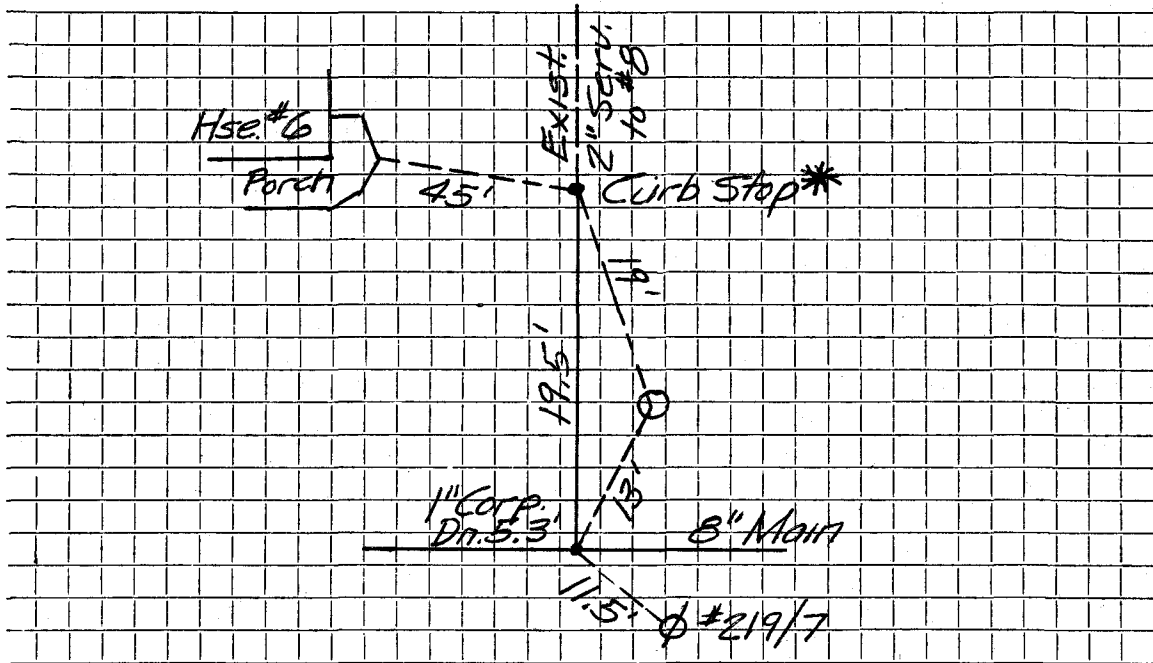

Connection made in Stratham Rd. Street. Work completed .....

Remarks: THIS SERVICE SHUT OFF AT CURB\* - NEW SERVICE IN DRAINWAY NOW IN USE. 12-11-84