

WATER SERVICE RECORD

Name

Service No.

Address

Location 12 SULLIVAN ST

Repair—Renewal New Service UP GRADE W/ALUMINUM


Date	Material	Amount	Total	Date	Amount
5/18/2000	48' 1" COPPER			6/1/57 36'	3/4" COPPER
	1 3/4" inc.				1 3/4" COP
	1 BUFFALO BOX				1 3/4" CURB STOP
	1" VALVE				

DATE \_\_\_\_\_

# TOWN OF LEXINGTON — BOARD OF PUBLIC WORKS

## WATER DIVISION

Sketch of Service Here

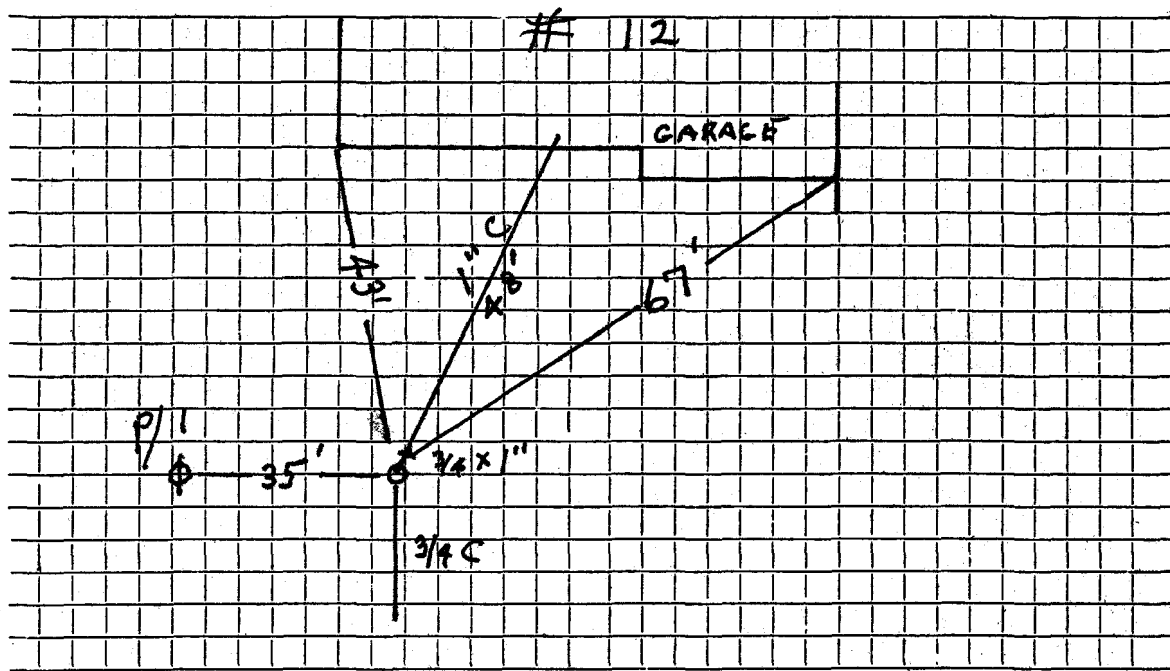

Connection made in ..... Street. Work completed .....

Remarks: .....  
.....  
.....