




DATE \_\_\_\_\_

TOWN OF LEXINGTON — BOARD OF PUBLIC WORKS

**WATER DIVISION**

Sketch of Service Here  
NO 28

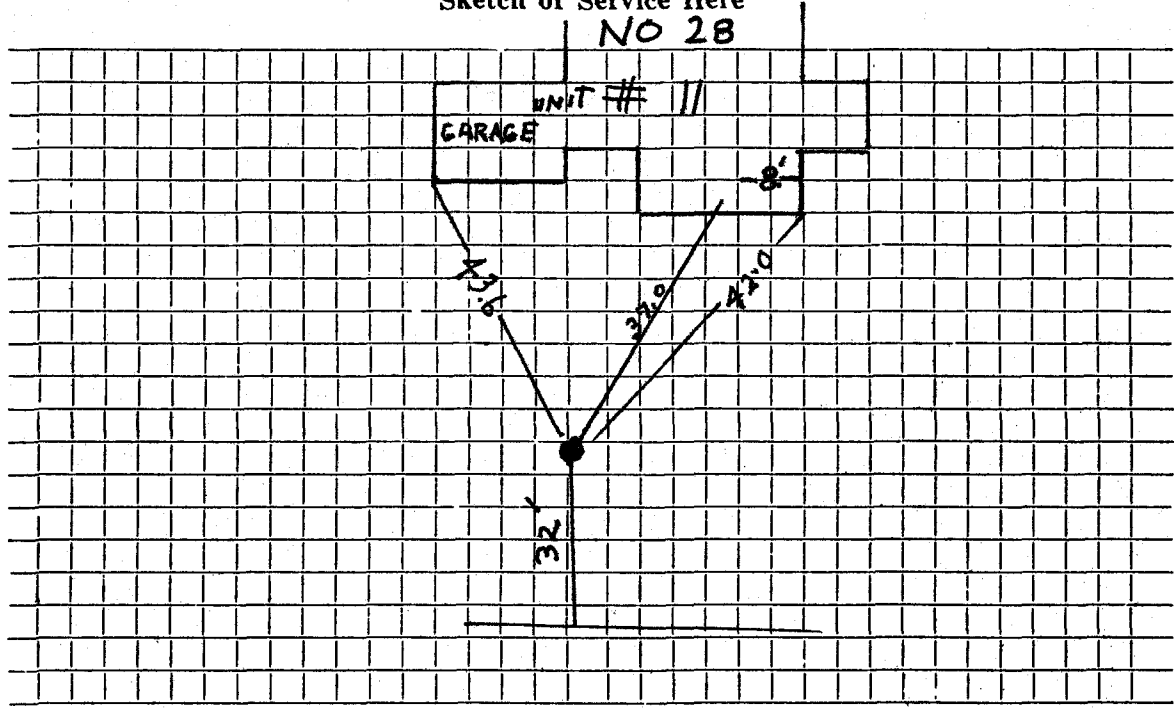

Connection made in ..... Street. Work completed DEC 2000 .....

Remarks: .....  
.....  
.....