


DATE _____

TOWN OF LEXINGTON — BOARD OF PUBLIC WORKS

WATER DIVISION

Sketch of Service Here

NO 30

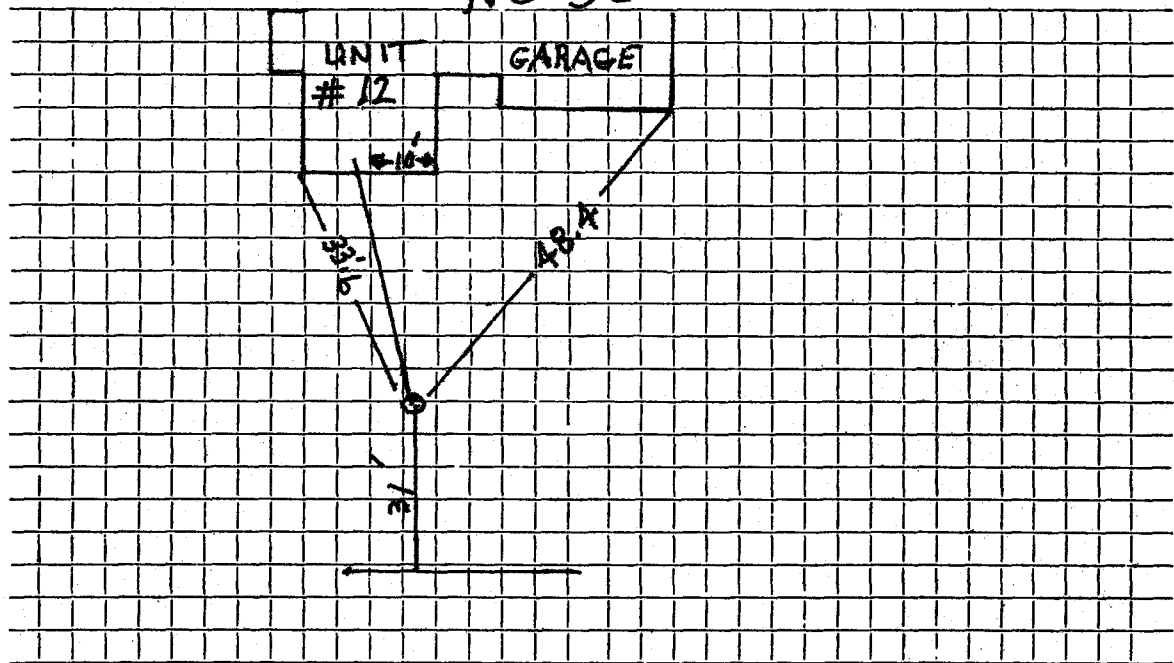

Connection made in Street. Work completed *Nov 2000*

Remarks:
.....
.....