


DATE _____

TOWN OF LEXINGTON — BOARD OF PUBLIC WORKS

WATER DIVISION

Sketch of Service Here
NO 32

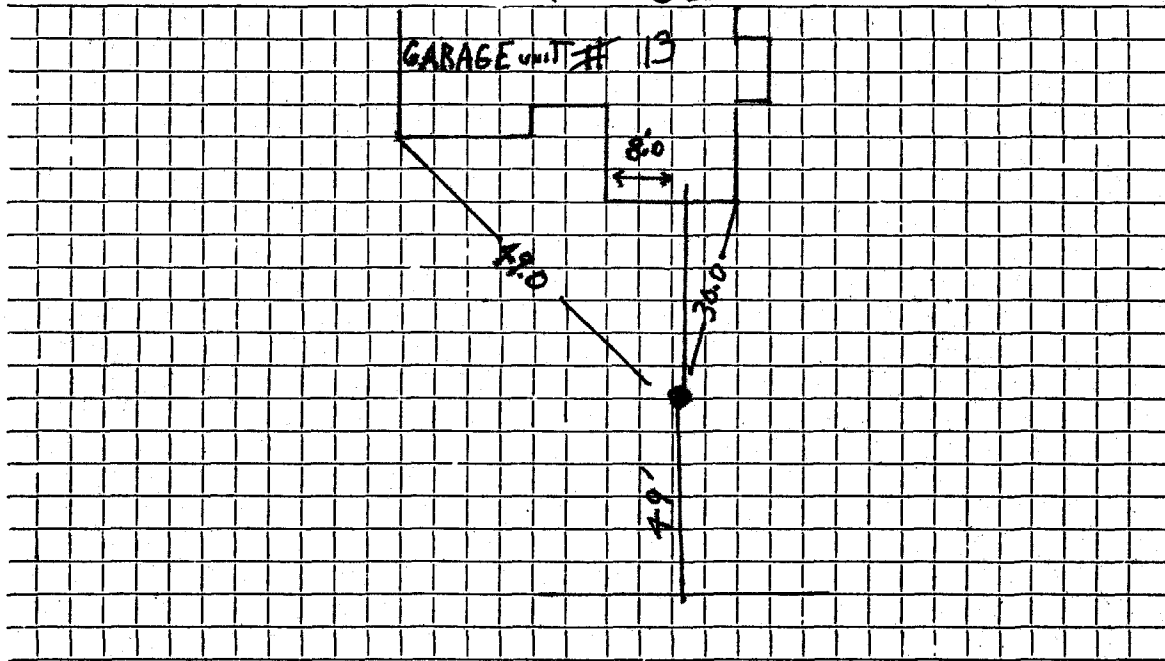

Connection made in Street. Work completed NOV 2000

Remarks:

.....

.....