

## **WATER SERVICE RECORD**

Name \_\_\_\_\_

**Service No.**

Address UNIT 14 SULLIVAN ST. IS NO 36

### **Location**

**Repair—Renewal—New Service** J. McLaughlin

DATE \_\_\_\_\_


TOWN OF LEXINGTON — BOARD OF PUBLIC WORKS  
WATER DIVISION

Sketch of Service Here

NO 36

Lot # 14

GARAGE

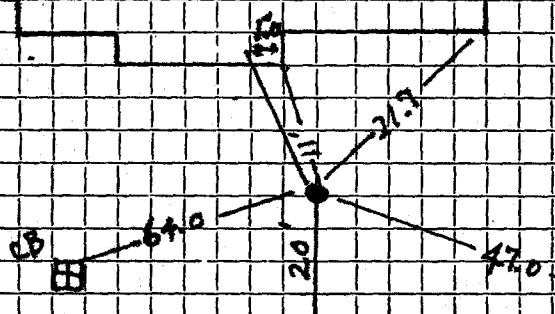

SULLIVAN ST

Connection made in ..... Street. Work completed .. 2001 .....

Remarks: .....