

WATER SERVICE RECORD

RS2483

#4143

Name Lloyd Goodrich

Service No. 64

Address 10 Summer Street (Existing service (Pit)) 1-30-80. #7217
G. Bevington #7314

Location Lexington

Repair ~~Work~~ - New Service Com. 6-16-52


Date	Material	Amount	Total	Date	Amount
5/23/52	Labor	54 22		4-22-52 Deposited	225 00
	10% overhead	5 42	59 64	6-16-52 Refunded	(24 89
	204' - 1" copper tubing @ .4048	82 57			<u>NON CHARGE</u> 200 11
	1 - 1" C x 1" I.W.H. stop & waste	5 12		5/23/52 Labor	10 00
	3 - 1" C x 1" C. unions @ 2.26	6 78		20' - 1" copper tubing @ .4048	8 09
	4 hrs. Littlefield shovel	28 00		1 - 1" C. corp-cock	5 61
	4 hrs. Allis Chalmers @ 3.00	12 00		1 - 1" C x 1" C. curb-cock	6 80
	1 hr. trailer	3 00		2 - 1" C x 1" I. unions @ 2.26	4 52
	1 hr. trucking	3 00		1 - box and rod	4 52
			200 11	1 hr. Littlefield shovel	7 00
				2 - 1" straight tail pieces @ .93	1 86
				1 hr. trucking	75
					<u>49 15</u>

DATE _____

TOWN OF LEXINGTON — BOARD OF PUBLIC WORKS

WATER DIVISION

Sketch of Service Here

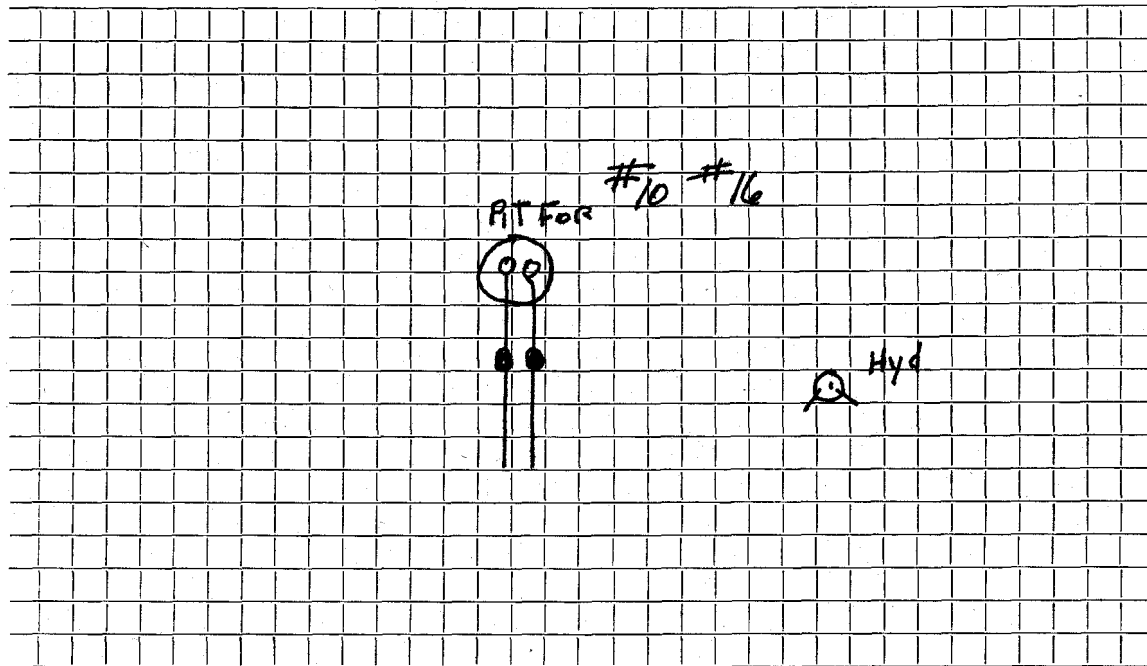

Connection made in ...Summer St... 16" w/ main Street.

Work completed


Remarks: ...P.I.T. DRIVE TO 10 A.....

DATE _____

TOWN OF LEXINGTON — BOARD OF PUBLIC WORKS

WATER DIVISION

Sketch of Service Here

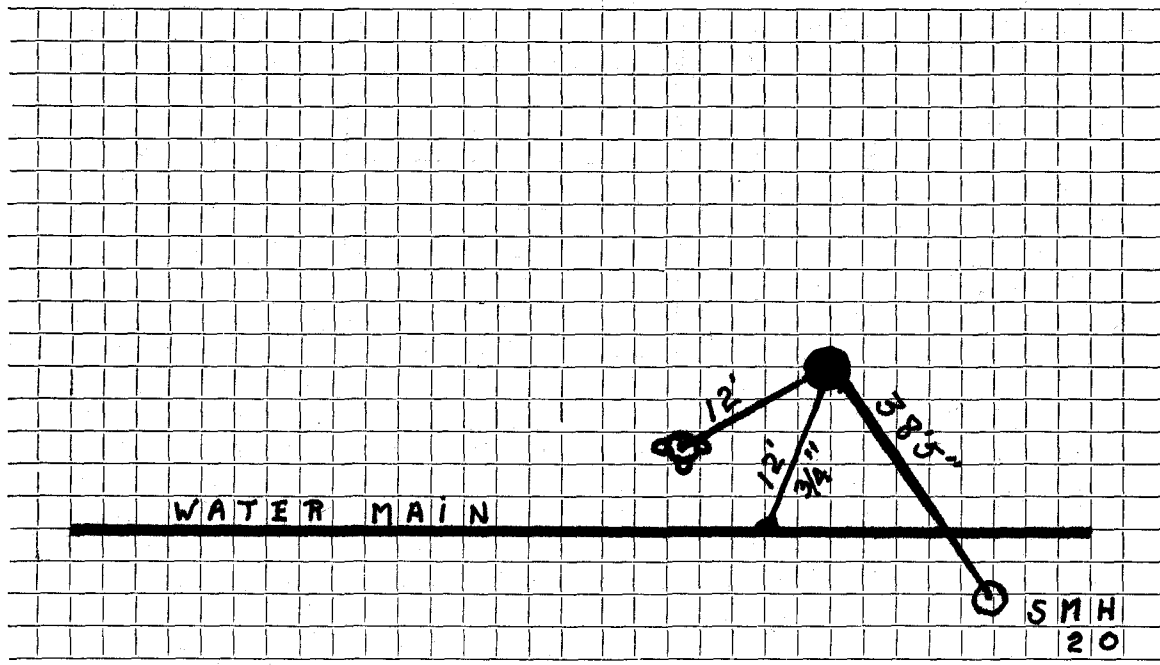

Connection made in Street. Work completed

Remarks:
.....
.....