




DATE 15 MARCH 1995

TOWN OF LEXINGTON — BOARD OF PUBLIC WORKS

WATER DIVISION

Sketch of Service Here

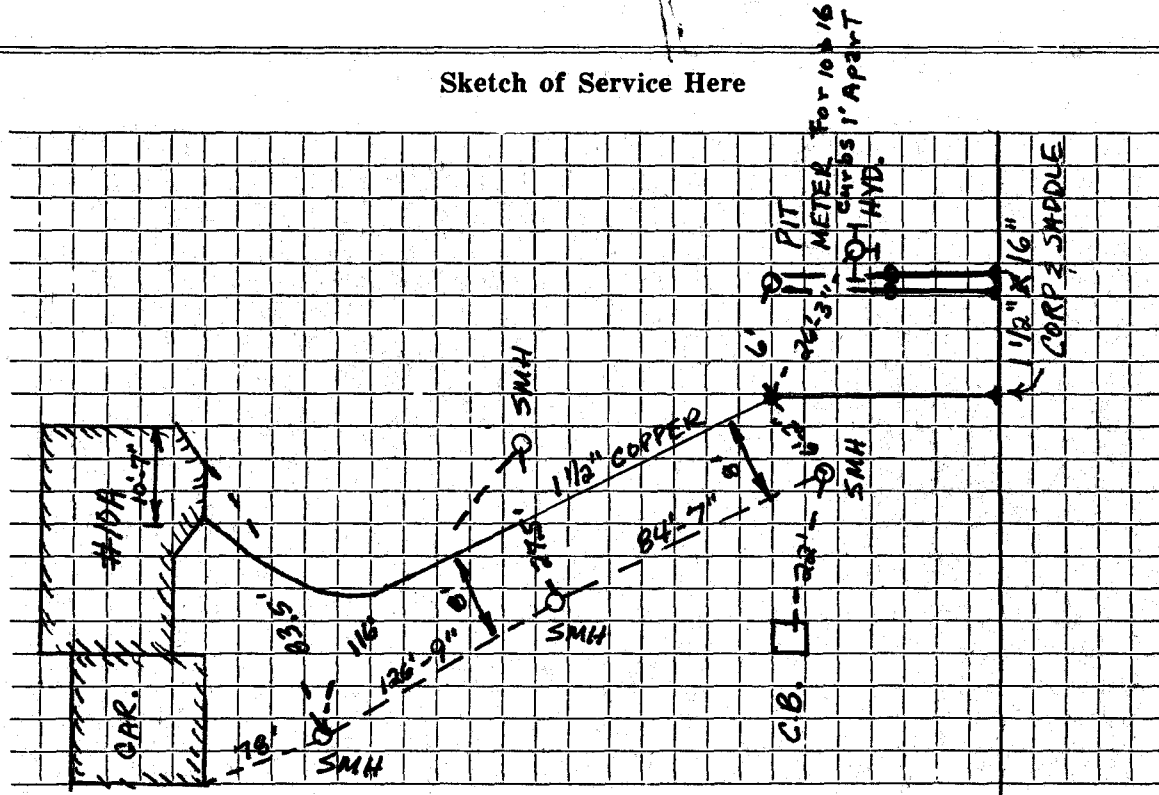

Connection made in SUMMER STREET Street. Work completed J.M. MCLAUGHLIN

Remarks: .....