


Water Service Tie Card  
**TOWN OF LEXINGTON**

15 Summer St

MASSACHUSETTS

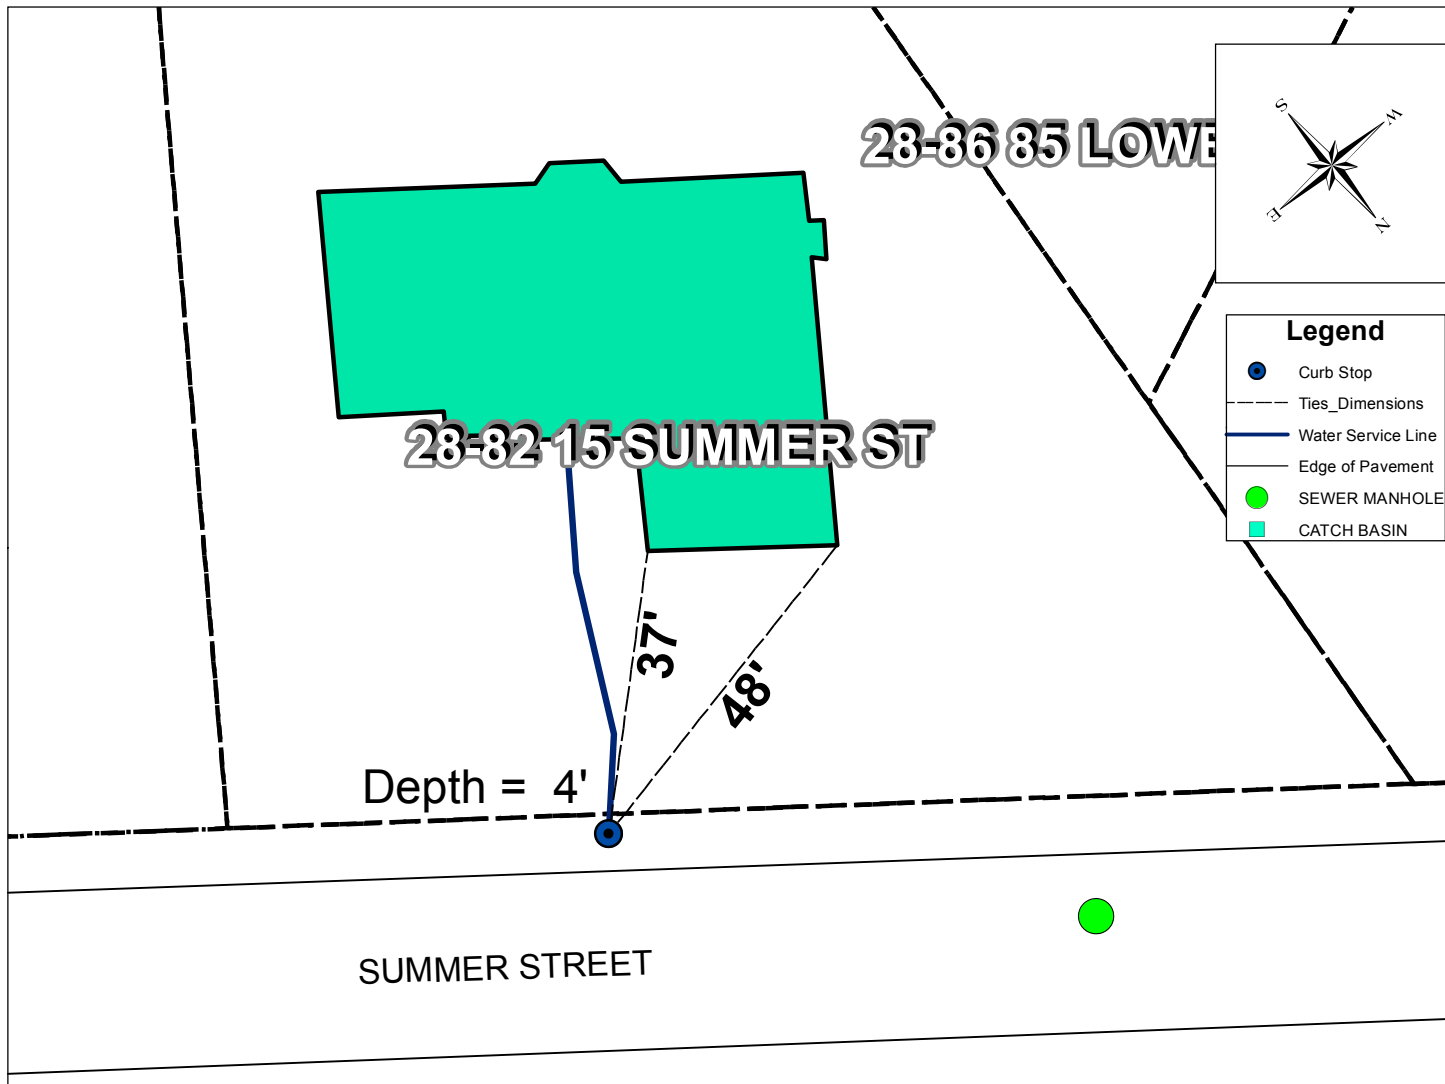

Address	Map and Lot	Permit Number	Contractor Name	Inspector
15 Summer St	28-82	6311	Caccavaro Const Inc	msprague
Date	Material	Depth of Cover	Amount	
7/30/2015	3/4" Copper type "k"	4 ft	1 ft	
	3/4" to 1" fitting	4 ft	1	
	1" Copper type "k"	4 ft	1 ft	
	1" Curb Valve and Buffalo Box	4 ft	1	
	1" Copper type "k"	4 ft	52 ft	
Type of work completed				
New 1" water service to house from curb stop. New house on lot old house removed.				